WATER WELL RECORD Form WWC-5 KSA 82a-1212

1 LOCATION OF WATER WELL: County: Sedgwick | Fraction: SE ¼ NW ¼ ¼ | Section Number: 21 | Township Number: T 27 S | Range Number: R [illegible] E/W

Distance and direction from nearest town or city street address of well if located within city?
Northwest Corner of the intersection of Mosley and 1st St, Wichita, Kansas

2 WATER WELL OWNER: The Coleman Company
RR#, St. Address, Box # : 250 N. St. Francis
City, State, ZIP Code : Wichita, Kansas 67202
Board of Agriculture, Division of Water Resources Application Number:

3 LOCATE WELL'S LOCATION WITH AN "X" IN SECTION BOX:

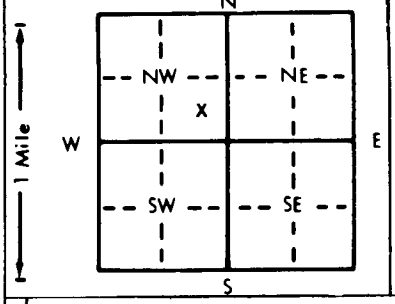

4 DEPTH OF COMPLETED WELL 27.0 ft. ELEVATION: n/a
Depth(s) Groundwater Encountered 1. 13.5 ft. 2. ft. 3. ft.
WELL'S STATIC WATER LEVEL 13.5 ft. below land surface measured on mo/day/yr 02/23/90
Pump test data: Well water was ft. after hours pumping gpm
Est. Yield gpm: Well water was ft. after hours pumping gpm
Bore Hole Diameter 6.5 in. to 27.5 ft., and in. to ft.
WELL WATER TO BE USED AS: 5 Public water supply 8 Air conditioning 11 Injection well
1 Domestic 3 Feedlot 6 Oil field water supply 9 Dewatering 12 Other (Specify below)
2 Irrigation 4 Industrial 7 Lawn and garden only (10) Monitoring well 132
Was a chemical/bacteriological sample submitted to Department? Yes No X; If yes, mo/day/yr sample was submitted
Water Well Disinfected? Yes No X

5 TYPE OF BLANK CASING USED: 5 Wrought iron 8 Concrete tile CASING JOINTS: Glued Clamped
1 Steel 3 RMP (SR) 6 Asbestos-Cement 9 Other (specify below) Welded
(2) PVC 4 ABS 7 Fiberglass Threaded X
Blank casing diameter 2.0 in. to 27.0 ft., Dia in. to ft., Dia in. to ft.
Casing height above land surface flush in., weight lbs./ft. Wall thickness or gauge No. Sch 40
TYPE OF SCREEN OR PERFORATION MATERIAL: (7) PVC 10 Asbestos-cement
1 Steel 3 Stainless steel 5 Fiberglass 8 RMP (SR) 11 Other (specify)
2 Brass 4 Galvanized steel 6 Concrete tile 9 ABS 12 None used (open hole)
SCREEN OR PERFORATION OPENINGS ARE: 5 Gauzed wrapped 8 Saw cut 11 None (open hole)
1 Continuous slot (3) Mill slot 6 Wire wrapped 9 Drilled holes
2 Louvered shutter 4 Key punched 7 Torch cut 10 Other (specify)
SCREEN-PERFORATED INTERVALS: From 17.0 ft. to 27.0 ft., From ft. to ft.
From 8.5 ft. to 18.5 ft., From ft. to ft.
GRAVEL PACK INTERVALS: From 6.5 ft. to 27.0 ft., From ft. to ft.
From ft. to ft., From ft. to ft.

6 GROUT MATERIAL: 1 Neat cement 2 Cement grout 3 Bentonite (4) Other volclay grout
Grout Intervals: From 1.0 ft. to 4.5 ft., From ft. to ft., From ft. to ft.
What is the nearest source of possible contamination:
1 Septic tank 4 Lateral lines 7 Pit privy 10 Livestock pens 14 Abandoned water well
2 Sewer lines 5 Cess pool 8 Sewage lagoon (11) Fuel storage 15 Oil well/Gas well
3 Watertight sewer lines 6 Seepage pit 9 Feedyard 12 Fertilizer storage 16 Other (specify below)
13 Insecticide storage
Direction from well? How many feet?

FROM	TO	LITHOLOGIC LOG	FROM	TO	PLUGGING INTERVALS
0.0	1.0	Fill Material:			
1.0	3.0	Clay: brown; 5% fine sand; medium to high plasticity.			
3.0	5.5	Clay: pale dark brown mottled; 10-15% gravels; medium to high plasticity.			
5.5	8.5	Silty Clay: pale brown to tan; 5-10% very fine sand; 5-10% gravels; low plasticity.			
8.5	13.5	Sand: pale yellowish-brown; fine well sorted; rounded.			
13.5	15.0	Sand: pale yellowish-brown; coarse; poorly sorted; sub-rounded; wet; 5% gravels.			
15.0	26.5	Sand: as above except saturated.			
26.5	27.5	Shale:			

7 CONTRACTOR'S OR LANDOWNER'S CERTIFICATION: This water well was (1) constructed, (2) reconstructed, or (3) plugged under my jurisdiction and was completed on (mo/day/year) 02/23/90 and this record is true to the best of my knowledge and belief. Kansas Water Well Contractor's License No. 471 This Water Well Record was completed on (mo/day/yr) 03/05/90 under the business name of HWS Technologies Inc. by (signature)

INSTRUCTIONS: Use typewriter or ball point pen. *PLEASE PRESS FIRMLY* and *PRINT* clearly. Please fill in blanks, underline or circle the correct answers. Send top three copies to Kansas Department of Health and Environment, Bureau of Water, Topeka, Kansas 66620-7320. Telephone: 913-296-5545. Send one to WATER WELL OWNER and retain one for your records.

OFFICE USE ONLY T R E/W SEC. ¼ ¼ ¼