


1 LOCATION OF WATER WELL: Fraction SE 1/4 NW 1/4 NE 1/4 Section Number 21 Township Number T 27 S Range Number R 1 **E**W
 County: Sedgwick

Distance and direction from nearest town or city street address of well if located within city?
 80' North and 15' West of 339 Indiana, Wichita, Kansas 52915012 MW-1

2 WATER WELL OWNER: Chromatech Corporation
 RR#, St. Address, Box #: 339 Indiana Board of Agriculture, Division of Water Resources
 City, State, ZIP Code: Wichita, Kansas 67214 Application Number:

3 LOCATE WELL'S LOCATION WITH AN "X" IN SECTION BOX: 4 DEPTH OF COMPLETED WELL 39.5 ft. ELEVATION: APPROX. Surface Elev.: 1297

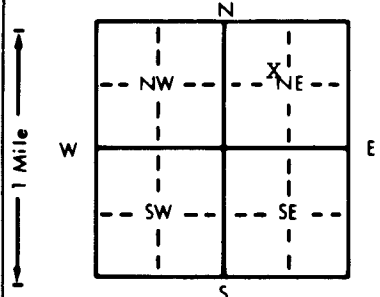

Depth(s) Groundwater Encountered 1. 17 ft. 2. ft. 3. ft.
 WELL'S STATIC WATER LEVEL 16.1 ft. below land surface measured on mo/day/yr 02/08/91
 Pump test data: Well water was ft. after hours pumping gpm
 Est. Yield N/A gpm Well water was ft. after hours pumping gpm
 Bore Hole Diameter 7.25 in. to 40 ft. and in. to ft.
 WELL WATER TO BE USED AS: 5 Public water supply 8 Air conditioning 11 Injection well
 1 Domestic 3 Feedlot 6 Oil field water supply 9 Dewatering 12 Other (Specify below)
 2 Irrigation 4 Industrial 7 Lawn and garden only 10 Monitoring well
 Was a chemical/bacteriological sample submitted to Department? Yes No X If yes, mo/day/yr sample was submitted Water Well Disinfected? Yes No X

5 TYPE OF BLANK CASING USED: 5 Wrought iron 8 Concrete tile CASING JOINTS: Glued Clamped
 1 Steel 3 RMP (SR) 6 Asbestos-Cement 9 Other (specify below) Welded
 2 PVC 4 ABS 7 Fiberglass Threaded X

Blank casing diameter 2 in. to 12 ft. Dia in. to ft. Dia in. to ft.
 Casing height above land surface -1 in. weight lbs./ft. Wall thickness or gauge No. Schedule 40

TYPE OF SCREEN OR PERFORATION MATERIAL: 7 PVC 10 Asbestos-cement
 1 Steel 3 Stainless steel 5 Fiberglass 8 RMP (SR) 11 Other (specify)
 2 Brass 4 Galvanized steel 6 Concrete tile 9 ABS 12 None used (open hole)

SCREEN OR PERFORATION OPENINGS ARE: 5 Gauzed wrapped 8 Saw cut 11 None (open hole)
 1 Continuous slot 3 Mill slot 6 Wire wrapped 9 Drilled holes
 2 Louvered shutter 4 Key punched 7 Torch cut 10 Other (specify)

SCREEN-PERFORATED INTERVALS: From 12.0 ft. to 39.5 ft. From ft. to ft.
 GRAVEL PACK INTERVALS: From 11.0 ft. to 40.0 ft. From ft. to ft.

6 GROUT MATERIAL: 1 Neat cement 2 Cement grout 3 Bentonite 4 Other
 Grout Intervals: From 0 ft. to 9.5 ft. From 9.5 ft. to 11 ft. From ft. to ft.

What is the nearest source of possible contamination:
 1 Septic tank 4 Lateral lines 7 Pit privy 10 Livestock pens 14 Abandoned water well
 2 Sewer lines 5 Cess pool 8 Sewage lagoon 11 Fuel storage 15 Oil well/Gas well
 3 Watertight sewer lines 6 Seepage pit 9 Feedyard 12 Fertilizer storage 16 Other (specify below)
 Uniform Cleaners
 Direction from well? North How many feet? 5

FROM	TO	LITHOLOGIC LOG	FROM	TO	PLUGGING INTERVALS
0	0.5	Fill (Silty Gravel, Light Gray)			
0.5	5.0	Lean Clay with Sand, Brown			
5.0	10.0	Lean Clay, Pale Brown			
10.0	16.0	Sandy Lean Clay, Pale Brown to Yellow-Brown			
16.0	19.0	Silty Sand, Brown to Gray-Brown			
19.0	33.5	Fine to Coarse Sand with Fine Gravels, Brown to Light Brown			
33.5	40.0	Highly Weathered Shale, Olive-Gray to Dark Gray			

7 CONTRACTOR'S OR LANDOWNER'S CERTIFICATION: This water well was (1) constructed, (2) reconstructed, or (3) plugged under my jurisdiction and was completed on (mo/day/year) 02/08/91 and this record is true to the best of my knowledge and belief. Kansas Water Well Contractor's License No. 416 This Water Well Record was completed on (mo/day/yr) 3/14/91 under the business name of Terracon Consultants by (signature)

OFFICE USE ONLY
T
R
EW
SEC.
1/4
1/4
1/4