


1 LOCATION OF WATER WELL: County: Sedgwick Fraction: SE 1/4 SW 1/4 NE 1/4 Section Number: 21 Township Number: T 27 S Range Number: R 1 E

Distance and direction from nearest town or city street address of well if located within city? 1700 E Douglas, Wichita KS

2 WATER WELL OWNER: Davis Moore Mazda
RR#, St. Address, Box #: 1700 E Douglas
City, State, ZIP Code: Wichita KS 67214
Board of Agriculture, Division of Water Resources
Application Number:

3 LOCATE WELL'S LOCATION WITH AN "X" IN SECTION BOX: 4 DEPTH OF COMPLETED WELL: 19.57 ft. ELEVATION: NA

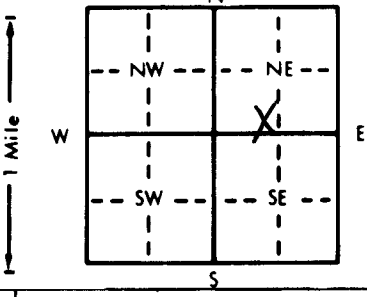

Depth(s) Groundwater Encountered: 1. NA ft. 2. NA ft. 3. NA ft.
WELL'S STATIC WATER LEVEL: 13.94 ft. below land surface measured on mo/day/yr 6-22-92
Pump test data: Well water was _____ ft. after _____ hours pumping _____ gpm
Est. Yield _____ gpm: Well water was _____ ft. after _____ hours pumping _____ gpm
Bore Hole Diameter: 12 in. to _____ ft., and _____ in. to _____ ft.
WELL WATER TO BE USED AS: 5 Public water supply 8 Air conditioning 11 Injection well
1 Domestic 3 Feedlot 6 Oil field water supply 9 Dewatering 12 Other (Specify below)
2 Irrigation 4 Industrial 7 Lawn and garden only 10 Monitoring well
Was a chemical/bacteriological sample submitted to Department? Yes _____ No X If yes, mo/day/yr sample was submitted _____
Water Well Disinfected? Yes _____ No X

5 TYPE OF BLANK CASING USED: 1 Steel 3 RMP (SR) 5 Wrought iron 8 Concrete tile CASING JOINTS: Glued _____ Clamped _____
2 PVC 4 ABS 6 Asbestos-Cement 9 Other (specify below) Welded _____
Blank casing diameter: 4 in. to _____ ft., Dia _____ in. to _____ ft., Dia _____ in. to _____ ft.
Casing height above land surface: Flush in., weight 2 lbs./ft. Wall thickness or gauge No. 25

TYPE OF SCREEN OR PERFORATION MATERIAL: 1 Steel 3 Stainless steel 5 Fiberglass 8 RMP (SR) 10 Asbestos-cement
2 Brass 4 Galvanized steel 6 Concrete tile 9 ABS 11 Other (specify) _____
12 None used (open hole)

SCREEN OR PERFORATION OPENINGS ARE: 1 Continuous slot 3 Mill slot 5 Gauzed wrapped 8 Saw cut 11 None (open hole)
2 Louvered shutter 4 Key punched 6 Wire wrapped 9 Drilled holes
7 Torch cut 10 Other (specify) _____

SCREEN-PERFORATED INTERVALS: From 19.32 ft. to 9.32 ft. From _____ ft. to _____ ft.
GRAVEL PACK INTERVALS: From 19.32 ft. to 7.5 ft. From _____ ft. to _____ ft.

6 GROUT MATERIAL: 1 Neat cement 2 Cement grout 3 Bentonite 4 Other
Grout Intervals: From 7.5 ft. to 1.0 ft. From _____ ft. to _____ ft. From _____ ft. to _____ ft.

What is the nearest source of possible contamination: 1 Septic tank 4 Lateral lines 7 Pit privy 10 Livestock pens 14 Abandoned water well
2 Sewer lines 5 Cess pool 8 Sewage lagoon 11 Fuel storage 15 Oil well/Gas well
3 Watertight sewer lines 6 Seepage pit 9 Feedyard 12 Fertilizer storage 16 Other (specify below)
Waste Oil UST

Direction from well? Southeast How many feet? ~120

FROM	TO	LITHOLOGIC LOG	FROM	TO	PLUGGING INTERVALS
0.0	0.5	Asphalt			
0.5	4.0	Clay w/ some scattered coarse sand Dark brown			
4.0	7.0	Clay; slightly sandy, brown			
7.0	15.0	Sand, very fine grained well sorted			
15.0	19.57	Sand; Fine to coarse grained moderately sorted			
Flush mount waiver granted on 6-10-92 for KDHE Trust fund for Davis-Moore Mazda by Don Taylor					

7 CONTRACTOR'S OR LANDOWNER'S CERTIFICATION: This water well was (1) constructed, (2) reconstructed, or (3) plugged under my jurisdiction and was completed on (mo/day/year) 6-16-92 and this record is true to the best of my knowledge and belief. Kansas Water Well Contractor's License No. 531 This Water Well Record was completed on (mo/day/yr) 6-24-92 under the business name of Geotechnical Services, Inc by (signature) Allison J. Jansen