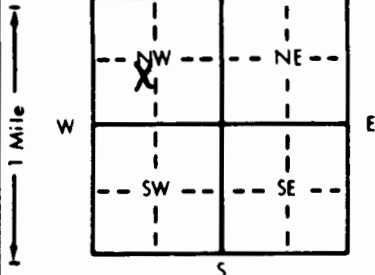


1 LOCATION OF WATER WELL: County: <u>Sedgewick</u>		Fraction <u>NE 1/4 SW 1/4 NW 1/4</u>	Section Number <u>21</u>	Township Number T <u>27</u> S	Range Number R <u>1</u> <u>EW</u>
Distance and direction from nearest town or city street address of well if located within city? <u>250 N. St. Francis Factory A westside</u>					
2 WATER WELL OWNER: RR#, St. Address, Box # : <u>The Coleman Company</u> City, State, ZIP Code : <u>250 N. St. Francis</u> <u>Wichita KS 67202</u>		SAW-4W Board of Agriculture, Division of Water Resources Application Number:			
3 LOCATE WELL'S LOCATION WITH AN "X" IN SECTION BOX: 		4 DEPTH OF COMPLETED WELL: <u>32</u> ft. ELEVATION: Depth(s) Groundwater Encountered 1. <u>15</u> ft. 2. <u>15</u> ft. 3. <u>15</u> ft. WELL'S STATIC WATER LEVEL <u>15</u> ft. below land surface measured on mo/day/yr <u>7-25-93</u> Pump test data: Well water was _____ ft. after _____ hours pumping _____ gpm Est. Yield _____ gpm: Well water was _____ ft. after _____ hours pumping _____ gpm Bore Hole Diameter <u>8</u> in. to <u>33.5</u> ft., and _____ in. to _____ ft. WELL WATER TO BE USED AS: 1 Domestic 3 Feedlot 6 Oil field water supply 11 Injection well 2 Irrigation 4 Industrial 7 Lawn and garden only 10 Dewatering 12 Other (Specify below) <u>Air Sparge well</u> Was a chemical/bacteriological sample submitted to Department? Yes _____ No <u>X</u> ; If yes, mo/day/yr sample was submitted _____ Water Well Disinfected? Yes _____ No <u>X</u>			
5 TYPE OF CASING USED: 1 Steel 3 RMP (SR) 2 PVC 4 ABS Blank casing diameter <u>2</u> in. to <u>31</u> ft., Dia _____ in. to _____ ft., Dia _____ in. to _____ ft. Casing height above land surface <u>30</u> in., weight _____ lbs./ft. Wall thickness or gauge No. _____		5 Wrought iron 8 Concrete tile CASING JOINTS: Glued _____ Clamped _____ 6 Asbestos-Cement 9 Other (specify below) Welded _____ 7 Fiberglass _____ Threaded <u>X</u> TYPE OF SCREEN OR PERFORATION MATERIAL: 1 Steel 2 Stainless steel 5 Fiberglass 8 RMP (SR) 11 Other (specify) _____ 2 Brass 4 Galvanized steel 6 Concrete tile 9 ABS 12 None used (open hole) SCREEN OR PERFORATION OPENINGS ARE: 1 Continuous slot 3 Mill slot 5 Gauzed wrapped 8 Saw cut 11 None (open hole) 2 Louvered shutter 4 Key punched 6 Wire wrapped 9 Drilled holes 7 Torch cut 10 Other (specify) _____ SCREEN-PERFORATED INTERVALS: From <u>30</u> ft. to <u>31</u> ft., From _____ ft. to _____ ft. From _____ ft. to _____ ft., From _____ ft. to _____ ft. GRAVEL PACK INTERVALS: From <u>33</u> ft. to <u>29</u> ft., From _____ ft. to _____ ft. From _____ ft. to _____ ft., From _____ ft. to _____ ft.			
6 GROUT MATERIAL: <u>Neat cement</u> 2 Cement grout 3 Bentonite 4 Other <u>w/ 5% bentonite</u> Grout intervals: From <u>29</u> ft. to <u>surface</u> ft., From _____ ft. to _____ ft., From _____ ft. to _____ ft. What is the nearest source of possible contamination: 1 Septic tank 4 Lateral lines 7 Pit privy 10 Livestock pens 14 Abandoned water well 2 Sewer lines 5 Cess pool 8 Sewage lagoon 11 Fuel storage 15 Oil well/Gas well 3 Watertight sewer lines 6 Seepage pit 9 Feedyard 12 Fertilizer storage 16 Other (specify below) _____ 13 Insecticide storage _____ Direction from well? <u>West</u> How many feet? <u>40</u>					
FROM TO LITHOLOGIC LOG FROM TO PLUGGING INTERVALS					
0	0.5	concrete			
0.5	5	Silt, clay, fine SAND			
5	7	SILT, w/ fine sand			
7	17	Silt SAND, fine grained			
17	33	SAND coarse to fine, trace of fine gravel			
33	33.5	CLAY olive green			
7 CONTRACTOR'S OR LANDOWNER'S CERTIFICATION: This water well was <u>(1) constructed</u> (2) reconstructed, or (3) plugged under my jurisdiction and was completed on (mo/day/year) <u>7-25-93</u> and this record is true to the best of my knowledge and belief. Kansas Water Well Contractor's License No. <u>517</u> This Water Well Record was completed on (mo/day/yr) <u>8/12/93</u> under the business name of <u>Groundwater Tech Inc</u> by (signature) <u>Albert Stout</u>					