WATER WELL RECORD Form WWC-5 KSA 82a-1212

1 LOCATION OF WATER WELL: County: Sedgwick	Fraction: NW ¼ SE ¼ NW ¼	Section Number: 21	Township Number: T 27 S	Range Number: R 1 (E) W

Distance and direction from nearest town or city street address of well if located within city?
250 N. St. Francis Factory A East side

2 WATER WELL OWNER: The Coleman Company
RR#, St. Address, Box # : 250 N. St. Francis
City, State, ZIP Code : Wichita KS 67202

SAW-3E
Board of Agriculture, Division of Water Resources
Application Number:

3 LOCATE WELL'S LOCATION WITH AN "X" IN SECTION BOX:

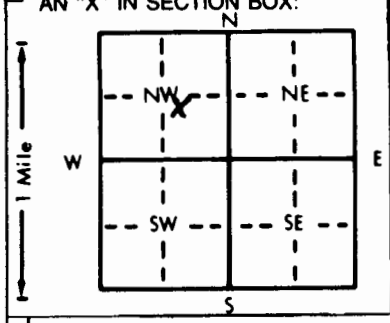

4 DEPTH OF COMPLETED WELL 39.5 ft. ELEVATION:
Depth(s) Groundwater Encountered 1. 15.2 ft. 2. ft. 3. ft.
WELL'S STATIC WATER LEVEL 15.2 ft. below land surface measured on mo/day/yr 7-15-93
Pump test data: Well water was ft. after hours pumping gpm
Est. Yield gpm: Well water was ft. after hours pumping gpm
Bore Hole Diameter 8 in. to 40 ft., and in. to ft.
WELL WATER TO BE USED AS: 5 Public water supply 8 Air conditioning 11 Injection well
1 Domestic 3 Feedlot 6 Oil field water supply 9 Dewatering (12) Other (Specify below)
2 Irrigation 4 Industrial 7 Lawn and garden only 10 Monitoring well Air Sparge Well
Was a chemical/bacteriological sample submitted to Department? Yes No X; If yes, mo/day/yr sample was submitted
Water Well Disinfected? Yes No X

5 TYPE OF BLANK CASING USED: 5 Wrought iron 8 Concrete tile CASING JOINTS: Glued Clamped
(1) Steel 3 RMP (SR) 6 Asbestos-Cement 9 Other (specify below) Welded
2 PVC 4 ABS 7 Fiberglass Threaded X
Blank casing diameter 2 in. to 37.4 ft., Dia in. to ft., Dia in. to ft.
Casing height above land surface 30 in., weight lbs./ft. Wall thickness or gauge No.
TYPE OF SCREEN OR PERFORATION MATERIAL: 7 PVC 10 Asbestos-cement
1 Steel (3) Stainless steel 5 Fiberglass 8 RMP (SR) 11 Other (specify)
2 Brass 4 Galvanized steel 6 Concrete tile 9 ABS 12 None used (open hole)
SCREEN OR PERFORATION OPENINGS ARE: 5 Gauzed wrapped 8 Saw cut 11 None (open hole)
1 Continuous slot 3 Mill slot (6) Wire wrapped 9 Drilled holes
2 Louvered shutter 4 Key punched 7 Torch cut 10 Other (specify)
SCREEN-PERFORATED INTERVALS: From 37.4 ft. to 39.4 ft., From ft. to ft.
From ft. to ft., From ft. to ft.
GRAVEL PACK INTERVALS: From 40 ft. to 35 ft., From ft. to ft.
From ft. to ft., From ft. to ft.

6 GROUT MATERIAL: (1) Neat cement 2 Cement grout 3 Bentonite 4 Other w/ 5% bentonite
Grout Intervals: From 35 ft. to Surface ft., From ft. to ft., From ft. to ft.
What is the nearest source of possible contamination: 10 Livestock pens 14 Abandoned water well
1 Septic tank 4 Lateral lines 7 Pit privy 11 Fuel storage 15 Oil well/Gas well
2 Sewer lines 5 Cess pool 8 Sewage lagoon 12 Fertilizer storage 16 Other (specify below)
3 Watertight sewer lines 6 Seepage pit 9 Feedyard 13 Insecticide storage Abandoned fuel storage
Direction from well? South How many feet? 50

FROM	TO	LITHOLOGIC LOG	FROM	TO	PLUGGING INTERVALS
0	0.5	Concrete			
0.5	4	Silty SAND fine			
4	9	Silty CLAY			
9	15	Silty fine SAND			
15	38	SAND coarse to fine w/ trace fine gravel			
38	40	Silty CLAY Olive green			

7 CONTRACTOR'S OR LANDOWNER'S CERTIFICATION: This water well was (1) constructed, (2) reconstructed, or (3) plugged under my jurisdiction and was completed on (mo/day/year) 7-15-93 and this record is true to the best of my knowledge and belief. Kansas Water Well Contractor's License No. 517 This Water Well Record was completed on (mo/day/yr) 8/12/93
under the business name of Groundwater Tech Inc. by (signature) Albert Stout

INSTRUCTIONS: Use typewriter or ball point pen. *PLEASE PRESS FIRMLY* and *PRINT* clearly. Please fill in blanks, underline or circle the correct answers. Send top three copies to Kansas Department of Health and Environment, Bureau of Water, Topeka, Kansas 66620-0001. Telephone: 913-296-5545. Send one to WATER WELL OWNER and retain one for your records.