


1 LOCATION OF WATER WELL: Sedgwick	FRACTION SW 1/4 NW 1/4 NE 1/4	Section Number 27	Township Number T 27 S	Range Number R 1E E/W
--	---	-----------------------------	----------------------------------	---------------------------------

Distance and direction from nearest town or city street address of well if located within city?

818 S. Poplar Wichita, Kansas

2 WATER WELL OWNER: PERKINS, Barbara RR#, ST. ADDRESS, BOX #: 634 Riverbend Estates Drive CITY, STATE, ZIP CODE: St. Charles, MO. 63303	Board of Agriculture, Division of Water Resources Application Number:
--	--

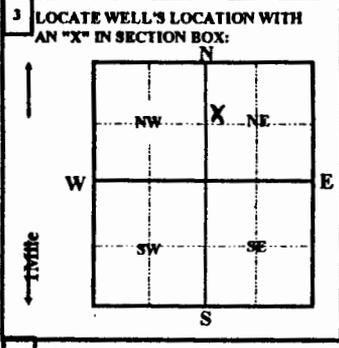

4 DEPTH OF COMPLETE WELL 25 ft. ELEVATION: Depth(s) groundwater Encountered 1 ft. WELL'S STATIC WATER LEVEL 3 FT. BELOW LAND SURFACE MEASURED ON 03/12/1993 Pump test data: Well water was _____ ft. after _____ hours pumping _____ gpm Est. Yield gpm: Well water was _____ ft. after _____ hours pumping _____ gpm Bore Hole Diameter _____ in. to _____ ft., and _____ in. to _____ ft. WELL WATER TO BE USED AS: 5 Public water supply 8 Air conditioning 11 Injection well 1 Domestic 3 Feedlot 6 Oil field water supply 9 Dewatering 12 Other (Specify below) 2 Irrigation 4 Industrial 7 Lawn and garden only 10 Monitoring well	Was a chemical/bacteriological sample submitted to Department? Yes _____ No _____ ; If yes, mo/day/yr sample was submitted _____ Water Well Disinfected? Yes <input checked="" type="checkbox"/> No _____
--	--

5 TYPE OF CASING USED:		5 Wrought iron	8 Concrete tile	CASING JOINTS: Glued Clamped	
1 Steel	3 RMP (SR)	6 Asbestos-Cement	9 Other (Specify below)	Welded	
2 PVC	4 ABS	7 Fiberglass		Threaded	
Blank casing Diameter 1 1/4 in. to _____ ft., Dia _____ in. to _____ ft.		Casing height above land surface 42 in., weight _____ lbs. / ft.		Wall thickness or gauge No.	
TYPE OF SCREEN OR PERFORATION MATERIAL:					
1 Steel	3 Stainless Steel	5 Fiberglass	8 RMP (SR)	11 other (specify)	
2 Brass	4 Galvanized steel	6 Concrete tile	9 ABS	12 None used (open hole)	
SCREEN OR PERFORATION OPENING ARE:					
1 Continuous slot	3 Mill slot	5 Gauzed wrapped	8 Saw cut	11 None (open hole)	
2 Louvered shutter	4 Key punched	6 Wire wrapped	9 Drilled holes		
SCREEN-PERFORATION INTERVALS: from _____ ft. to _____ ft., From _____ ft. to _____ ft.					
GRAVEL PACK INTERVALS: from _____ ft. to _____ ft., From _____ ft. to _____ ft.					

6 GROUT MATERIAL: 1 Neat cement		2 Cement grout	3 Bentonite	4 Other	
Grout intervals: From 0 ft. to 9 ft., From _____ ft. to _____ ft.					
What is the nearest source of possible contamination:					
1 Septic tank	4 Lateral lines	7 Pit privy	10 Livestock pens	14 Abandon water well	
2 Sewer lines	5 Cess pool	8 Sewage lagoon	11 Fuel storage	15 Oil well/Gas well	
3 Watertight sewer lines	6 Seepage pit	9 Feedyard	12 Fertilizer storage	16 Other (specify below)	
Direction form well? North			How many feet? 5		

FROM	TO	LITHOLOGIC LOG	FROM	TO	PLUGGING INTERVALS
			0	9	cement grout
			9	20	bentonite hole plug
			20	25	chlorinated sand and gravel
<div style="font-size: 2em; font-weight: bold; margin-bottom: 10px;">RECEIVED</div> <div style="font-size: 1.2em; margin-bottom: 10px;">MAY 07 1993</div> <div style="font-size: 1.5em; font-weight: bold;">BUREAU OF WATER</div>					

7 CONTRACTOR'S OR LANDOWNER'S CERTIFICATION: This water well was (1) constructed, (2) reconstructed, or (3) plugged under my jurisdiction and was completed on (mo/day/year) 03/12/1993 and this record is true to the best of my knowledge and belief. Kansas Water Well Contractor's License No. 236 This Water Well Record was completed on (mo/day/yr) 03/12/93 Under the business name of Harp Well & Pump Service, Inc. by (signature) <i>Jane Frederick</i>	
---	--