


1 LOCATION OF WATER WELL: County: Sedgwick Fraction NW 1/4 SW 1/4 NW 1/4 Section Number 27 Township Number T 27 S Range Number R 1 EW

Distance and direction from nearest town or city street address of well if located within city?  
 220' North & 300' East of Intersection of Gilbert & Hydraulic, Wichita, Kansas 01948011 MW-1

2 WATER WELL OWNER: Blair House Apartments RR#, St. Address, Box #: 888 South Hydraulic City, State, ZIP Code: Wichita, Kansas 67211 Board of Agriculture, Division of Water Resources Application Number:

3 LOCATE WELL'S LOCATION WITH AN "X" IN SECTION BOX:

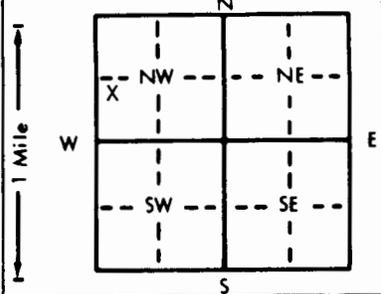

4 DEPTH OF COMPLETED WELL: 23.0 ft. ELEVATION: Approx. Surface Elev.: 98.0  
 Depth(s) Groundwater Encountered 1. 10.0 ft. 2. ft. 3. ft.  
 WELL'S STATIC WATER LEVEL: 15.5 ft. below land surface measured on mo/day/yr 05/06/94  
 Pump test data: Well water was ft. after hours pumping gpm  
 Est. Yield gpm: Well water was ft. after hours pumping gpm  
 Bore Hole Diameter: 8.25 in. to 23.0 ft., and in. to ft.  
 WELL WATER TO BE USED AS:  
 1 Domestic 3 Feedlot 6 Oil field water supply 9 Dewatering 12 Other (Specify below)  
 2 Irrigation 4 Industrial 7 Lawn and garden only 10 Monitoring well  
 Was a chemical/bacteriological sample submitted to Department? Yes No X; If yes, mo/day/yr sample was submitted Water Well Disinfected? Yes No X

5 TYPE OF BLANK CASING USED:  
 1 Steel 3 RMP (SR) 5 Wrought iron 8 Concrete tile CASING JOINTS: Glued Clamped  
 2 PVC 4 ABS 6 Asbestos-Cement 9 Other (specify below) Welded  
 7 Fiberglass Threaded X  
 Blank casing diameter 2 in. to 8.0 ft., Dia in. to ft., Dia in. to ft.  
 Casing height above land surface 24.5 in., weight lbs./ft. Wall thickness or gauge No. Schedule 40

TYPE OF SCREEN OR PERFORATION MATERIAL:  
 1 Steel 3 Stainless steel 5 Fiberglass 8 RMP (SR) 10 Asbestos-cement  
 2 Brass 4 Galvanized steel 6 Concrete tile 9 ABS 11 Other (specify)  
 12 None used (open hole)

SCREEN OR PERFORATION OPENINGS ARE:  
 1 Continuous slot 3 Mill slot 5 Gauzed wrapped 8 Saw cut 11 None (open hole)  
 2 Louvered shutter 4 Key punched 6 Wire wrapped 9 Drilled holes  
 7 Torch cut 10 Other (specify)

SCREEN-PERFORATED INTERVALS: From 8.0 ft. to 23.0 ft., From ft. to ft.  
 From ft. to ft., From ft. to ft.  
 GRAVEL PACK INTERVALS: From 6.0 ft. to 23.0 ft., From ft. to ft.  
 From ft. to ft., From ft. to ft.

6 GROUT MATERIAL: 1 Neat cement 2 Cement grout 3 Bentonite 4 Other  
 Grout Intervals: From 0.0 ft. to 4.5 ft., From 4.5 ft. to 6.0 ft., From ft. to ft.

What is the nearest source of possible contamination:  
 1 Septic tank 4 Lateral lines 7 Pit privy 10 Livestock pens 14 Abandoned water well  
 2 Sewer lines 5 Cess pool 8 Sewage lagoon 11 Fuel storage 15 Oil well/Gas well  
 3 Watertight sewer lines 6 Seepage pit 9 Feedyard 12 Fertilizer storage 16 Other (specify below)  
 13 Insecticide storage  
 Direction from well? How many feet?

| FROM | TO   | LITHOLOGIC LOG   | FROM | TO | PLUGGING INTERVALS |
|------|------|--|------|----|--------------------|
| 0.0  | 1.0  | Fill: Asphalt and Gravel                                 |      |    |                    |
| 1.0  | 3.0  | Silty, Sandy, Lean to Fat Clay; Dark Brown               |      |    |                    |
| 3.0  | 5.0  | Silty Lean Clay; Brown, Trace Fine Sand                  |      |    |                    |
| 5.0  | 6.0  | Silty Fine Sand; Brown                                   |      |    |                    |
| 6.0  | 8.0  | Silty, Lean to Fat Clay; Dark Brown, With Some Fine Sand |      |    |                    |
| 8.0  | 10.0 | Lean to Fat Clay; Dark Brown to Black                    |      |    |                    |
| 10.0 | 15.0 | Lean to Fat Clay; Dark Brown With Sand                   |      |    |                    |
| 15.0 | 22.5 | Fine to Coarse Sand; Brown                               |      |    |                    |
| 22.5 | 23.0 | Clayey Shale; Gray                                       |      |    |                    |

7 CONTRACTOR'S OR LANDOWNER'S CERTIFICATION: This water well was (1) constructed, (2) reconstructed, or (3) plugged under my jurisdiction and was completed on (mo/day/year) 05/06/94 and this record is true to the best of my knowledge and belief. Kansas Water Well Contractor's License No. 416. This Water Well Record was completed on (mo/day/yr) 6-8-94 under the business name of Terracon Consultants, Inc. by (signature) Steve Fisher

INSTRUCTIONS: Use typewriter or ball point pen. PLEASE PRESS FIRMLY and PRINT clearly. Please fill in blanks, underline or circle the correct answers. Send top three copies to Kansas Department of Health and Environment, Bureau of Water, Topeka, Kansas 66620-0001. Telephone: 913-296-5545. Send one to WATER WELL OWNER and retain one for your records.