


1 LOCATION OF WATER WELL: Fraction NW 1/4 NW 1/4 NW 1/4 Section Number 29 Township Number T 27 S Range Number R 1 E
 County: Sedgewick Distance and direction from nearest town or city street address of well if located within city?

824 S. Seneca

2 WATER WELL OWNER: Mr. Coleman
 RR#, St. Address, Box #: 824 S. Seneca
 City, State, ZIP Code: Wichita State 67213
 Board of Agriculture, Division of Water Resources
 Application Number: none

3 LOCATE WELL'S LOCATION WITH AN "X" IN SECTION BOX: 4 DEPTH OF COMPLETED WELL: 25 ft. ELEVATION: 1300

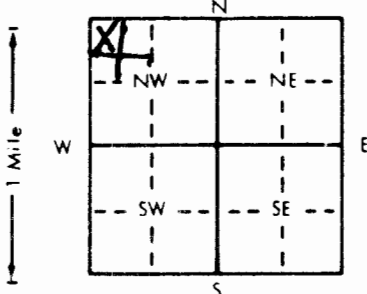

Depth(s) Groundwater Encountered 1. 12 ft. 2. ft. 3. ft.

WELL'S STATIC WATER LEVEL 12 ft. below land surface measured on mo/day/yr 6-23-94

Pump test data: Well water was ft. after hours pumping gpm

Est. Yield gpm: Well water was ft. after hours pumping gpm

Bore Hole Diameter in. to ft., and in. to ft.

WELL WATER TO BE USED AS: 5 Public water supply 8 Air conditioning 11 Injection well

1 Domestic 3 Feedlot 6 Oil field water supply 9 Dewatering 12 Other (Specify below)

2 Irrigation 4 Industrial 7 Lawn and garden only 10 Monitoring well

Was a chemical/bacteriological sample submitted to Department? Yes No X If yes, mo/day/yr sample was submitted

Water Well Disinfected? Yes No X

5 TYPE OF BLANK CASING USED: 5 Wrought iron 8 Concrete tile CASING JOINTS: Glued Clamped

1 Steel 3 RMP (SR)

2 PVC 4 ABS

6 Asbestos-Cement

9 Other (specify below)

Welded

Threaded X

Blank casing diameter in. to ft., Dia. in. to ft., Dia. in. to ft.

Casing height above land surface in. weight lbs./ft. Wall thickness or gauge No.

TYPE OF SCREEN OR PERFORATION MATERIAL: 7 PVC 10 Asbestos-cement

1 Steel 3 Stainless steel

5 Fiberglass

8 RMP (SR)

11 Other (specify)

2 Brass 4 Galvanized steel

6 Concrete tile

9 ABS

12 None used (open hole)

SCREEN OR PERFORATION OPENINGS ARE: 5 Gauzed wrapped 8 Saw cut 11 None (open hole)

1 Continuous slot 3 Mill slot

6 Wire wrapped

9 Drilled holes

2 Louvered shutter 4 Key punched

7 Torch cut

10 Other (specify) Sand Point

SCREEN-PERFORATED INTERVALS: From NA ft. to NA ft., From ft. to ft.

From ft. to ft., From ft. to ft.

GRAVEL PACK INTERVALS: From ft. to ft., From ft. to ft.

From ft. to ft., From ft. to ft.

6 GROUT MATERIAL: 1 Neat cement 2 Cement grout 3 Bentonite 4 Other

Grout Intervals: From 12 ft. to 0 ft., From ft. to ft., From ft. to ft.

What is the nearest source of possible contamination: 10 Livestock pens 14 Abandoned water well

1 Septic tank 4 Lateral lines

7 Pit privy

11 Fuel storage

15 Oil well/Gas well

2 Sewer lines 5 Cess pool

8 Sewage lagoon

12 Fertilizer storage

16 Other (specify below)

3 Watertight sewer lines 6 Seepage pit

9 Feedyard

13 Insecticide storage

Direction from well? north How many feet? 20

FROM TO LITHOLOGIC LOG FROM TO PLUGGING INTERVALS

12 0 Cement Grout