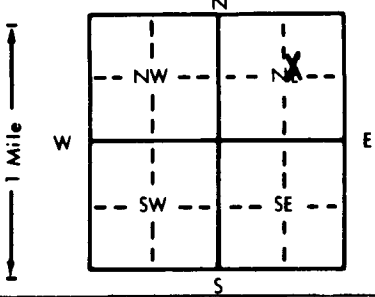


1 LOCATION OF WATER WELL:		Fraction	Section Number	Township Number	Range Number
County: <u>Sedgwick</u>		SW $\frac{1}{4}$ NE $\frac{1}{4}$ NE $\frac{1}{4}$	32	T 27 S	R 1 <u>EW</u>
Distance and direction from nearest town or city street address of well if located within city?					
1650 S. Water Wichita KS					
2 WATER WELL OWNER: City of Wichita					
RR#, St. Address, Box # : 1900 E. 9th Street					
City, State, ZIP Code : Wichita KS 67214					
Board of Agriculture, Division of Water Resources					
Application Number:					
3 LOCATE WELL'S LOCATION WITH AN "X" IN SECTION BOX:		4 DEPTH OF COMPLETED WELL: 35.7 ft. ELEVATION: N.A.			
		Depth(s) Groundwater Encountered 1. 18.5 ft. 2. ft. 3. ft.			
		WELL'S STATIC WATER LEVEL: N.A. ft. below land surface measured on mo/day/yr			
		Pump test data: Well water was ft. after hours pumping gpm			
		Est. Yield gpm: Well water was ft. after hours pumping gpm			
Bore Hole Diameter: 11 in. to ft., and in. to ft.		WELL WATER TO BE USED AS:			
1 Domestic 3 Feedlot 6 Oil field water supply 9 Dewatering 12 Other (Specify below)		5 Public water supply 8 Air conditioning 11 Injection well			
2 Irrigation 4 Industrial 7 Lawn and garden only 10 Monitoring well					
Was a chemical/bacteriological sample submitted to Department? Yes No <u>XX</u> ; If yes, mo/day/yr sample was submitted					
Water Well Disinfected? Yes No <u>XX</u>					
5 TYPE OF BLANK CASING USED:					
1 Steel 3 RMP (SR) 5 Wrought iron 8 Concrete tile CASING JOINTS: Glued Clamped					
2 PVC 4 ABS 6 Asbestos-Cement 9 Other (specify below) Welded					
7 Fiberglass Threaded Flush					
Blank casing diameter: 4 in. to ft., Dia. in. to ft., Dia. in. to ft.					
Casing height above land surface: in., weight: 2 lbs./ft. Wall thickness or gauge No. 25					
TYPE OF SCREEN OR PERFORATION MATERIAL:					
1 Steel 3 Stainless steel 5 Fiberglass 8 RMP (SR) 10 Asbestos-cement					
2 Brass 4 Galvanized steel 6 Concrete tile 9 ABS 11 Other (specify)					
12 None used (open hole)					
SCREEN OR PERFORATION OPENINGS ARE:					
1 Continuous slot 3 Mill slot 5 Gauzed wrapped 8 Saw cut 11 None (open hole)					
2 Louvered shutter 4 Key punched 7 7 Torch cut 9 Drilled holes 10 Other (specify)					
SCREEN-PERFORATED INTERVALS: From 25.8 ft. to 35.7 ft., From ft. to ft.					
GRAVEL PACK INTERVALS: From 23.5 ft. to 35.7 ft., From ft. to ft.					
6 GROUT MATERIAL:					
1 Neat cement 2 Cement grout 3 Bentonite 4 Other					
Grout Intervals: From 20.5 ft. to 20 ft., From 20 ft. to 1 ft., From ft. to ft.					
What is the nearest source of possible contamination:					
1 Septic tank 4 Lateral lines 7 Pit privy 10 Livestock pens 14 Abandoned water well					
2 Sewer lines 5 Cess pool 8 Sewage lagoon 11 Fuel storage 15 Oil well/Gas well					
3 Watertight sewer lines 6 Seepage pit 9 Feedyard 12 Fertilizer storage 16 Other (specify below) still checking					
13 Insecticide storage					
Direction from well? How many feet?					
FROM	TO	LITHOLOGIC LOG	FROM	TO	PLUGGING INTERVALS
0.5	7.1	Silty sandy clay.			
7.1	8.5	Fine to medium sand.			
8.5	13.5	Fine to very coarse sand.			
13.5	17.5	Fine to medium sand.			
17.5	34.0	Fine to very coarse sand.			
34.0	35.7	Silty clay.			
7 CONTRACTOR'S OR LANDOWNER'S CERTIFICATION: This water well was (1) constructed, (2) reconstructed, or (3) plugged under my jurisdiction and was completed on (mo/day/year) 11-27-91 and this record is true to the best of my knowledge and belief. Kansas Water Well Contractor's License No. 531 This Water Well Record was completed on (mo/day/yr) 12-31-91 under the business name of GST by (signature) Allison Irwin					