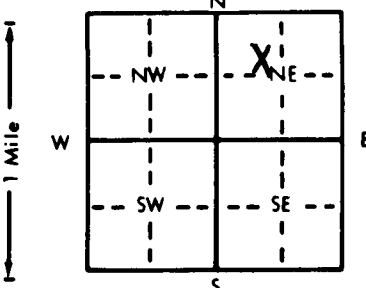


1 LOCATION OF WATER WELL: County: SEDGWICK		Fraction SE 1/4 NW 1/4 NE 1/4	Section Number 33	Township Number T 27 S	Range Number R 1 E
Distance and direction from nearest town or city street address of well if located within city? 1730 S. LAURA ST.					
2 WATER WELL OWNER: RR#, St. Address, Box # : City, State, ZIP Code :			Board of Agriculture, Division of Water Resources Application Number:		
BOEING COMPANY P.O. BOX 7730 WICHITA, KS 67277					
3 LOCATE WELL'S LOCATION WITH AN "X" IN SECTION BOX:		4 DEPTH OF COMPLETED WELL: 32' ft. ELEVATION:			
		Depth(s) Groundwater Encountered 1. 12.6 ft. 2. 12.0 ft. 3. 2.0 ft. WELL'S STATIC WATER LEVEL 12.6 ft. below land surface measured on mo/day/yr 7/19/93 Pump test data: Well water was _____ ft. after _____ hours pumping _____ gpm Est. Yield _____ gpm: Well water was _____ ft. after _____ hours pumping _____ gpm Bore Hole Diameter _____ in. to _____ ft., and _____ in. to _____ ft. WELL WATER TO BE USED AS: 5 Public water supply 8 Air conditioning 11 Injection well 1 Domestic WAS 3 Feedlot 6 Oil field water supply 9 Dewatering 12 Other (Specify below) 2 Irrigation 4 Industrial 7 Lawn and garden only 10 Monitoring well Was a chemical/bacteriological sample submitted to Department? Yes _____ No X ; If yes, mo/day/yr sample was submitted _____ Water Well Disinfected? Yes _____ No X			
5 TYPE OF BLANK CASING USED:					
1 Steel 2 PVC Blank casing diameter _____ in. to _____ ft., Dia _____ in. to _____ ft. Casing height above 3 ft. below land surface _____ in., weight _____ lbs./ft. Wall thickness or gauge No. _____		3 RMP (SR) 4 ABS 5 Wrought iron 6 Asbestos-Cement 7 Fiberglass		8 Concrete tile 9 Other (specify below) _____ CASING JOINTS: Glued _____ Clamped _____ Welded _____ Threaded _____	
TYPE OF SCREEN OR PERFORATION MATERIAL:					
1 Steel 2 Brass SCREEN OR PERFORATION OPENINGS ARE: 1 Continuous slot 2 Louvered shutter		3 Stainless steel 4 Galvanized steel 5 Fiberglass 6 Concrete tile 5 Gauzed wrapped 6 Wire wrapped 7 Torch cut		7 PVC 8 RMP (SR) 9 ABS 10 Asbestos-cement 11 Other (specify) NA 12 None used (open hole) 8 Saw cut 9 Drilled holes 10 Other (specify) NA 11 None (open hole)	
SCREEN-PERFORATED INTERVALS: From _____ ft. to _____ ft., From _____ ft. to _____ ft., From _____ ft. to _____ ft.					
GRAVEL PACK INTERVALS: From _____ ft. to _____ ft., From _____ ft. to _____ ft., From _____ ft. to _____ ft.					
6 GROUT MATERIAL: 1 Neat cement 2 Cement grout 3 Bentonite 4 Other _____					
Grout Intervals: From 12.0 ft. to 2.0 ft., From _____ ft. to _____ ft., From _____ ft. to _____ ft.					
What is the nearest source of possible contamination: 1 Septic tank 4 Lateral lines 7 Pit privy 10 Livestock pens 14 Abandoned water well 2 Sewer lines 5 Cess pool 8 Sewage lagoon 11 Fuel storage 15 Oil well/Gas well 3 Watertight sewer lines 6 Seepage pit 9 Feedyard 12 Fertilizer storage 16 Other (specify below) _____ 13 Insecticide storage NA Direction from well? NA How many feet? NA					
FROM		TO		LITHOLOGIC LOG	
FROM		TO		PLUGGING INTERVALS	
				32.0 12.0 SAND	
				12.0 2.0 BENTONITE	
7 CONTRACTOR'S OR LANDOWNER'S CERTIFICATION: This water well was (1) constructed, (2) reconstructed, or (3) plugged under my jurisdiction and was completed on (mo/day/year) 7/19/93 and this record is true to the best of my knowledge and belief. Kansas Water Well Contractor's License No. 531 This Water Well Record was completed on (mo/day/yr) 7/19/93 under the business name of BSI by (signature) Kerrin W. Johnson					