


1 LOCATION OF WATER WELL: Fraction SE 1/4 SE 1/4 SE 1/4 Section Number 36 Township Number T 27 S Range Number R 1 E
 County: SEDGWICK
 Distance and direction from nearest town or city street address of well if located within city?
5800 E PAWNEE

2 WATER WELL OWNER: CESSNA MW61 Board of Agriculture, Division of Water Resources
 RR#, St. Address, Box #: 5800 E PAWNEE
 City, State, ZIP Code: WICHITA KS Application Number:

3 LOCATE WELL'S LOCATION WITH AN "X" IN SECTION BOX:

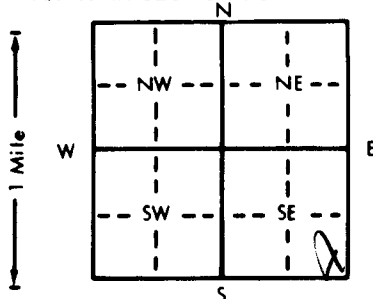

4 DEPTH OF COMPLETED WELL: 57.5 ft. ELEVATION:

Depth(s) Groundwater Encountered 1. 52 ft. 2. 57.5 ft. 3. 57.5 ft.

WELL'S STATIC WATER LEVEL 52 ft. below land surface measured on mo/day/yr




WELL WATER TO BE USED AS: 5 Public water supply 8 Air conditioning 11 Injection well

1 Domestic 3 Feedlot 6 Oil field water supply 9 Dewatering 12 Other (Specify below)

2 Irrigation 4 Industrial 7 Lawn and garden only 10 Monitoring well

Was a chemical/bacteriological sample submitted to Department? Yes No No Yes If yes, mo/day/yr sample was submitted

Water Well Disinfected? Yes No No Yes

5 TYPE OF BLANK CASING USED: 5 Wrought iron 8 Concrete tile CASING JOINTS: Glued Clamped

1 Steel 3 RMP (SR) 6 Asbestos-Cement 9 Other (specify below) Welded Threaded

2 PVC 4 ABS 7 Fiberglass 7 PVC Threaded Threaded



TYPE OF SCREEN OR PERFORATION MATERIAL: 10 Asbestos-cement

1 Steel 3 Stainless steel 5 Fiberglass 8 RMP (SR) 11 Other (specify)

2 Brass 4 Galvanized steel 6 Concrete tile 9 ABS 12 None used (open hole)

SCREEN OR PERFORATION OPENINGS ARE: 5 Gauzed wrapped 8 Saw cut 11 None (open hole)

1 Continuous slot 3 Mill slot 6 Wire wrapped 9 Drilled holes

2 Louvered shutter 4 Key punched 7 Torch cut 10 Other (specify)





What is the nearest source of possible contamination: 10 Livestock pens 14 Abandoned water well

1 Septic tank 4 Lateral lines 7 Pit privy 11 Fuel storage 15 Oil well/Gas well

2 Sewer lines 5 Cess pool 8 Sewage lagoon 12 Fertilizer storage 16 Other (specify below)

3 Watertight sewer lines 6 Seepage pit 9 Feedyard 13 Insecticide storage PLANT

Direction from well? S How many feet? 500

FROM TO LITHOLOGIC LOG FROM TO PLUGGING INTERVALS

0 4 FILL 0 4 FILL

4 26 SILTY CLAY & SHALE 4 26 SILTY CLAY & SHALE

26 TO CLAY & SHALE & GYP 26 TO CLAY & SHALE & GYP


7 CONTRACTOR'S OR LANDOWNER'S CERTIFICATION: This water well was (1) constructed, (2) reconstructed, or (3) plugged under my jurisdiction and was completed on (mo/day/year) 8/10/91 and this record is true to the best of my knowledge and belief. Kansas Water Well Contractor's License No. 102 This Water Well Record was completed on (mo/day/yr) 8/30/91 under the business name of Wayne Wesler by (signature) Wayne Wesler