

USE TYPEWRITER OR BALL
POINT PEN-PRESS FIRMLY,
PRINT CLEARLY.

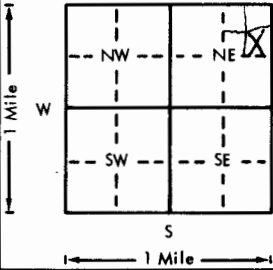
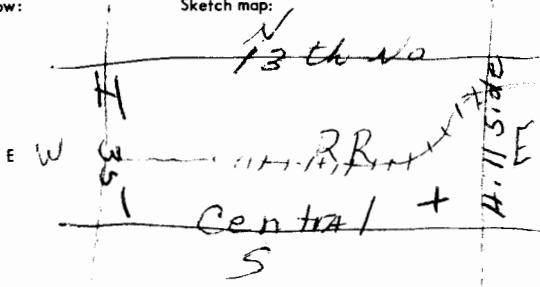
WATER WELL RECORD
KSA 82a-1201-1215

Kansas Department of Health and
Environment-Division of Environment
(Water well Contractors)
Topeka, Kansas 66620

NW NE SW SE Sec. 15

27s

1 E

1. Location of well:		County Sedgwick	Fraction SE 1/4 NE 1/4 NE 1/4	Section number 20	Township number T 27 S	Range number R 1 E
2. Distance and direction from nearest town or city: Street address of well location if in city: 652 N Green				3. Owner of well: CA Munsell R.R. or street: 652 N Green City, state, zip code: Wichita, Kans		
4. Locate with "X" in section below:		Sketch map:		Bore hole dia. 8 in. Completion date: 7/20/77 Well depth 40 ft.		
				7. <input checked="" type="checkbox"/> Cable tool <input checked="" type="checkbox"/> Rotary <input type="checkbox"/> Driven <input type="checkbox"/> Dug <input type="checkbox"/> Hollow rod <input type="checkbox"/> Jetted <input type="checkbox"/> Bored <input type="checkbox"/> Reverse rotary		
5. Type and color of material				From	To	8. Use: <input checked="" type="checkbox"/> Domestic <input type="checkbox"/> Public supply <input type="checkbox"/> Industry <input type="checkbox"/> Irrigation <input type="checkbox"/> Air conditioning <input type="checkbox"/> Stock <input type="checkbox"/> Lawn <input type="checkbox"/> Oil field water <input type="checkbox"/> Other
BLACK DIRT				0	4	9. Casing: Material Styrene Above or below Threaded <input type="checkbox"/> Welded <input type="checkbox"/> Surface 12 in. RMP <input type="checkbox"/> PVC <input type="checkbox"/> Weight 100 lbs./ft. Dia. 4 in. to 40 ft. depth Wall Thickness: inches or Dia. <input type="checkbox"/> in. to <input type="checkbox"/> ft. depth gage No. 100
BROWN CLAY				4	20	10. Screen: Manufacturer's name Sunflow Type 100 Dia. 4" Slot/gauze Slot Length 5 Set between 35 ft. and 40 ft. Gravel pack? No Size range of material 4"
YELLOW SAND				20	30	11. Static water level: 28 ft. below land surface Date 7/20/77
WHITE SAND				30	40	12. Pumping level below land surfaces: ____ ft. after ____ hrs. pumping ____ g.p.m. ____ ft. after ____ hrs. pumping ____ g.p.m. Estimated maximum yield 10 g.p.m.
						13. Water sample submitted: ____ mo./day/yr. Yes <input checked="" type="checkbox"/> No <input type="checkbox"/> Date ____
						14. Well head completion: ____ Pitless adapter 12 Inches above grade
						<input checked="" type="checkbox"/> Well grouted? With: <input checked="" type="checkbox"/> Neat cement <input type="checkbox"/> Bentonite <input type="checkbox"/> Concrete Depth: From 0 ft. to 10 ft.
						<input checked="" type="checkbox"/> Nearest source of possible contamination ft. 50 Direction E Type Sewer Well disinfected upon completion? <input checked="" type="checkbox"/> Yes <input type="checkbox"/> No
						17. Pump: <input checked="" type="checkbox"/> Not installed Manufacturer's name ____ Model number ____ HP ____ Volts ____ Length of drop pipe ____ ft. capacity ____ g.p.m. Type: <input type="checkbox"/> Submersible <input type="checkbox"/> Turbine <input type="checkbox"/> Jet <input type="checkbox"/> Reciprocating <input type="checkbox"/> Centrifugal <input type="checkbox"/> Other
						20. Water well contractor's certification: This well was drilled under my jurisdiction and this report is true to the best of my knowledge and belief. Jet Drilling 313 Business name 257 N Sahar License No. ____ Address Wichita, Kansas Signed Wm J. Jordan Date 7/20/77 Authorized representative
18. Elevation:		19. Remarks:				
Topography: <input type="checkbox"/> Hill <input type="checkbox"/> Slope <input checked="" type="checkbox"/> Upland <input type="checkbox"/> Valley						

Forward the white, blue and pink copies to the Department of Health and Environment

Form WWC-5