


1 LOCATION OF WATER WELL: Fraction SW 1/4 NW 1/4 SW 1/4 Section Number 29 Township Number T 27 S Range Number R 1 E  
 County: SEDGWICK

Distance and direction from nearest town or city street address of well if located within city?  
SAME AS OWNER

2 WATER WELL OWNER: CENTRAL MOTOR POOL  
 RR#, St. Address, Box #: 1015 STILLWELL WICHITA KS 57213 Board of Agriculture, Division of Water Resources  
 City, State, ZIP Code: Application Number:

3 LOCATE WELL'S LOCATION WITH AN "X" IN SECTION BOX:

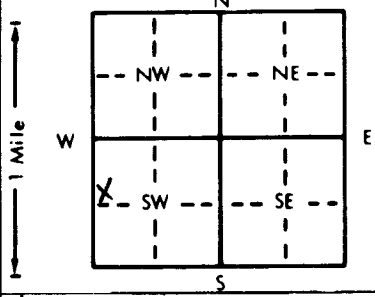

4 DEPTH OF COMPLETED WELL: 12 ft. ELEVATION:

Depth(s) Groundwater Encountered 1. 11.7 ft. 2. — ft. 3. — ft.  
 WELL'S STATIC WATER LEVEL NA ft. below land surface measured on mo/day/yr —  
 Pump test data: Well water was — ft. after — hours pumping — gpm  
 Est. Yield NA gpm: Well water was — ft. after — hours pumping — gpm  
 Bore Hole Diameter 7.25 in. to 12 ft., and — in. to — ft.  
 WELL WATER TO BE USED AS: 5 Public water supply 8 Air conditioning 11 Injection well  
 1 Domestic 3 Feedlot 6 Oil field water supply 9 Dewatering 12 Other (Specify below)  
 2 Irrigation 4 Industrial 7 Lawn and garden only 10 Monitoring well SOIL BORING  
 Was a chemical/bacteriological sample submitted to Department? Yes — No X; If yes, mo/day/yr sample was submitted  
 Water Well Disinfected? Yes — No X

5 TYPE OF BLANK CASING USED: NONE 5 Wrought iron 8 Concrete tile CASING JOINTS: Glued — Clamped —  
 1 Steel 3 RMP (SR) 6 Asbestos-Cement 9 Other (specify below) Welded —  
 2 PVC 4 ABS 7 Fiberglass Threaded —

Blank casing diameter — in. to — ft., Dia. — in. to — ft., Dia. — in. to — ft.  
 Casing height above land surface NA in., weight — lbs./ft. Wall thickness or gauge No. —  
 TYPE OF SCREEN OR PERFORATION MATERIAL: NA 7 PVC 10 Asbestos-cement  
 1 Steel 3 Stainless steel 5 Fiberglass 8 RMP (SR) 11 Other (specify) —  
 2 Brass 4 Galvanized steel 6 Concrete tile 9 ABS 12 None used (open hole)

SCREEN OR PERFORATION OPENINGS ARE: NA 5 Gauzed wrapped 8 Saw cut 11 None (open hole)  
 1 Continuous slot 3 Mill slot 6 Wire wrapped 9 Drilled holes  
 2 Louvered shutter 4 Key punched 7 Torch cut 10 Other (specify) —

SCREEN-PERFORATED INTERVALS: From NA ft. to — ft., From — ft. to — ft.  
 From — ft. to — ft., From — ft. to — ft.

~~SAND GRAVEL~~ PACK INTERVALS: From 10 ft. to 12 ft., From — ft. to — ft.  
 From — ft. to — ft., From — ft. to — ft.

6 GROUT MATERIAL: 1 Neat cement 2 Cement grout 3 Bentonite 4 Other CUTTINGS  
 Grout Intervals: From 7 ft. to 10 ft., From GL ft. to 7 ft., From — ft. to — ft.

What is the nearest source of possible contamination:  
 1 Septic tank 4 Lateral lines 7 Pit privy 10 Livestock pens 14 Abandoned water well  
 2 Sewer lines 5 Cess pool 8 Sewage lagoon 11 Fuel storage 15 Oil well/Gas well  
 3 Watertight sewer lines 6 Seepage pit 9 Feedyard 12 Fertilizer storage 16 Other (specify below)  
CONTAMINATED SITE

Direction from well? — How many feet? —

FROM	TO	LITHOLOGIC LOG	FROM	TO	PLUGGING INTERVALS
<u>GL</u>	<u>1.5</u>	<u>FILL - SD + GRAVEL</u>			
<u>1.5</u>	<u>5</u>	<u>FIVE BR. SD. EXPANSE TAN</u>			
<u>5</u>	<u>10</u>	<u>SAND - FIVE TO MED LT BR.</u>			
<u>10</u>	<u>12</u>	<u>SAND MED TO COARSE</u>			
		<u>WATER SAT FT 11.7 - SLIGHT ODOUR</u>			

7 CONTRACTOR'S OR LANDOWNER'S CERTIFICATION: This water well was (1) constructed, (2) reconstructed, or (3) plugged under my jurisdiction and was completed on (mo/day/year) 07-13-93 and this record is true to the best of my knowledge and belief. Kansas Water Well Contractor's License No. 479 This Water Well Record was completed on (mo/day/yr) 07-29-93 under the business name of EBBERTS DRILLING by (signature) Sharon Ebberts

INSTRUCTIONS: Use typewriter or ball point pen. PLEASE PRESS FIRMLY and PRINT clearly. Please fill in blanks, underline or circle the correct answers. Send top three copies to Kansas Department of Health and Environment, Bureau of Water, Topeka, Kansas 66620-0001. Telephone: 913-296-5545. Send one to WATER WELL OWNER and retain one for your records.