

1 LOCATION OF WATER WELL:	Fraction	Section Number	Township Number	Range Number
County: <u>Sedgwick</u>	<u>SW</u> 1/4 <u>NW</u> 1/4 <u>NE</u> 1/4	<u>36</u>	T <u>28</u> S	R <u>1</u> <u>EW</u>


Distance and direction from nearest town or city street address of well if located within city?

2116 S. Edgemoor, Wichita, KS, 67218

27

2 WATER WELL OWNER:	Board of Agriculture, Division of Water Resources
RR#, St. Address, Box #:	Application Number:
City, State, ZIP Code:	

3 LOCATE WELL'S LOCATION WITH AN "X" IN SECTION BOX:	4 DEPTH OF COMPLETED WELL: <u>25</u> ft. ELEVATION:
--	---

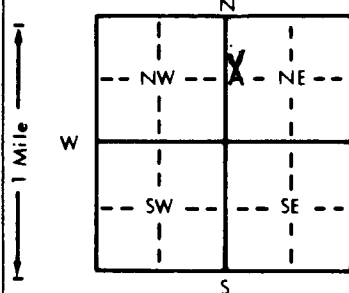

Depth(s) Groundwater Encountered	1. ft.	2. ft.	3. ft.
WELL'S STATIC WATER LEVEL	<u>20</u> ft. below land surface measured on mo/day/yr	<u>7-11-94</u>	
Pump test data:	Well water was ft. after hours pumping	gpm	
Est. Yield	gpm: Well water was ft. after hours pumping	gpm	
Bore Hole Diameter	in. to ft., and in. to ft.		
WELL WATER TO BE USED AS:	5 Public water supply	8 Air conditioning	11 Injection well
1 Domestic	3 Feedlot	6 Oil field water supply	9 Dewatering
2 Irrigation	4 Industrial	<u>7 Lawn and garden only</u>	10 Monitoring well
Was a chemical/bacteriological sample submitted to Department? Yes.....No.....	If yes, mo/day/yr sample was submitted		
Water Well Disinfected? Yes.....No.....			

5 TYPE OF BLANK CASING USED:	5 Wrought iron	8 Concrete tile	CASING JOINTS: Glued.....Clamped.....
<u>1 Steel</u>	3 RMP (SR)	6 Asbestos-Cement	9 Other (specify below)
2 PVC	4 ABS	7 Fiberglass	10 Asbestos-cement
Blank casing diameter	<u>4</u> in. to <u>25</u> ft., Dia	in. to ft., Dia	in. to ft.
Casing height above land surface	<u>3' below</u> weight	lbs./ft. Wall thickness or gauge No.	
TYPE OF SCREEN OR PERFORATION MATERIAL:	7 PVC	10 Asbestos-cement	
1 Steel	3 Stainless steel	5 Fiberglass	8 RMP (SR)
2 Brass	4 Galvanized steel	6 Concrete tile	9 ABS
SCREEN OR PERFORATION OPENINGS ARE:	5 Gauzed wrapped	8 Saw cut	11 None (open hole)
1 Continuous slot	3 Mill slot	6 Wire wrapped	9 Drilled holes
2 Louvered shutter	4 Key punched	7 Torch cut	10 Other (specify)
SCREEN-PERFORATED INTERVALS:	From ft. to ft.	From ft. to ft.	From ft. to ft.
GRAVEL PACK INTERVALS:	From ft. to ft.	From ft. to ft.	From ft. to ft.

6 GROUT MATERIAL:	1 Neat cement	2 Cement grout	3 Bentonite	4 Other
Grout Intervals:	From ft. to ft.	From ft. to ft.	From ft. to ft.	From ft. to ft.
What is the nearest source of possible contamination:	1 Septic tank	4 Lateral lines	7 Pit privy	10 Livestock pens
2 Sewer lines	5 Cess pool	8 Sewage lagoon	11 Fuel storage	<u>14 Abandoned water well</u>
3 Watertight sewer lines	6 Seepage pit	9 Feedyard	12 Fertilizer storage	15 Oil well/Gas well
Direction from well?	<u>West</u>	How many feet?	<u>2'</u>	<u>Termite Treatment</u>

FROM	TO	LITHOLOGIC LOG	FROM	TO	PLUGGING INTERVALS
			<u>25'</u>	<u>20'</u>	<u>44 Cu. ft. Sand + Gravel</u>
			<u>20'</u>	<u>3'</u>	<u>1.5 Cu. ft. Cement Grout</u>
			<u>3'</u>	<u>0'</u>	<u>Topsoil + Clay</u>

7 CONTRACTOR'S OR LANDOWNER'S CERTIFICATION: This water well was (1) constructed, (2) reconstructed, or (3) plugged under my jurisdiction and was completed on (mo/day/year) <u>7-11-94</u> and this record is true to the best of my knowledge and belief. Kansas Water Well Contractor's License No. <u>580</u> This Water Well Record was completed on (mo/day/yr) <u>7-11-94</u> under the business name of <u>Boyd Moore Const. Co.</u> by (signature) <u>Boyd A. Moore</u>
--