


1 LOCATION OF WATER WELL: County: <b>Sedgwick</b>	Fraction <b>NW 1/4 SW 1/4 SE 1/4</b>	Section Number <b>21</b>	Township Number <b>T 28 27 S</b>	Range Number <b>R 1 EW</b>
--	---	-----------------------------	-------------------------------------	-------------------------------

Distance and direction from nearest town or city street address of well if located within city?  
**1116 E. 1st Street Wichita**

2 WATER WELL OWNER: **City of Wichita**  
 RR#, St. Address, Box #: **1900 E. 9th Street**  
 City, State, ZIP Code: **Wichita KS 67214**

Board of Agriculture, Division of Water Resources  
 Application Number:

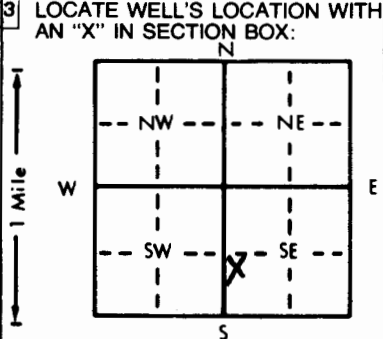

4 DEPTH OF COMPLETED WELL: **20.3** ft. ELEVATION: **N.A.**

Depth(s) Groundwater Encountered 1. **14.5** ft. 2. ft. 3. ft.

WELL'S STATIC WATER LEVEL **N.A.** ft. below land surface measured on mo/day/yr

Pump test data: Well water was ft. after hours pumping gpm  
 Est. Yield gpm: Well water was ft. after hours pumping gpm

Bore Hole Diameter: **11** in. to ft., and in. to ft.

WELL WATER TO BE USED AS:  
 5 Public water supply 8 Air conditioning 11 Injection well  
 1 Domestic 3 Feedlot 6 Oil field water supply 9 Dewatering 12 Other (Specify below)  
 2 Irrigation 4 Industrial 7 Lawn and garden only **10 Monitoring well**

Was a chemical/bacteriological sample submitted to Department? Yes.....No **XX**.....; If yes, mo/day/yr sample was submitted

Water Well Disinfected? Yes No **XX**

5 TYPE OF BLANK CASING USED:  
 1 Steel 3 RMP (SR) 5 Wrought iron 8 Concrete tile CASING JOINTS: Glued.....Clamped.....  
 2 **PVC** 4 ABS 6 Asbestos-Cement 9 Other (specify below) Welded.....  
 7 Fiberglass Threaded... Flush.....

Blank casing diameter **4** in. to ft., Dia in. to ft., Dia in. to ft.  
 Casing height above land surface: Flush..... in., weight **2** lbs./ft. Wall thickness or gauge No. **25**"

TYPE OF SCREEN OR PERFORATION MATERIAL:  
 1 Steel 3 Stainless steel 5 Fiberglass 8 RMP (SR) 10 Asbestos-cement  
 2 Brass 4 Galvanized steel 6 Concrete tile 9 ABS 11 Other (specify).....  
 12 None used (open hole)

SCREEN OR PERFORATION OPENINGS ARE:  
 1 Continuous slot 3 Mill slot 5 Gauzed wrapped 8 Saw cut 11 None (open hole)  
 2 Louvered shutter 4 Key punched 6 Wire wrapped 9 Drilled holes  
 7 Torch cut 10 Other (specify).....

SCREEN-PERFORATED INTERVALS: From **10.3** ft. to **20.3** ft., From ft. to ft.  
 From ft. to ft., From ft. to ft.

GRAVEL PACK INTERVALS: From **7.3** ft. to **20.3** ft., From ft. to ft.  
 From ft. to ft., From ft. to ft.

6 GROUT MATERIAL: 1 Neat cement 2 **Cement grout** 3 **Bentonite** 4 Other.....

Grout Intervals: From **7.3** ft. to **6.7** ft., From **6.7** ft. to **1.0** ft., From ft. to ft.

What is the nearest source of possible contamination:  
 1 Septic tank 4 Lateral lines 7 Pit privy 10 Livestock pens 14 Abandoned water well  
 2 Sewer lines 5 Cess pool 8 Sewage lagoon 11 Fuel storage 15 Oil well/Gas well  
 3 Watertight sewer lines 6 Seepage pit 9 Feedyard 12 Fertilizer storage 16 **Other (specify below)**  
 13 Insecticide storage Still Checking.....

Direction from well? How many feet?

FROM	TO	LITHOLOGIC LOG	FROM	TO	PLUGGING INTERVALS
0.0	0.5	Grass, sandy silty clay loam.			
0.5	3.8	Clayey silty sand loam.			
3.8	10.0	Silty fine sand.			
10.0	20.3	Sand. Fine to very coarse.			

7 CONTRACTOR'S OR LANDOWNER'S CERTIFICATION: This water well was **(1) constructed**, (2) reconstructed, or (3) plugged under my jurisdiction and was completed on (mo/day/year) **12-18-91** and this record is true to the best of my knowledge and belief. Kansas Water Well Contractor's License No. **531**. This Water Well Record was completed on (mo/day/yr) **1-10-92** under the business name of **Geotechnical services, Inc.** by (signature) *Alison Irwin*