


1 LOCATION OF WATER WELL: Fraction NE 1/4 NW 1/4 Section Number 18 Township Number T 27 S Range Number R 1 E

Distance and direction from nearest town or city street address or well if located within city?

1245 N River Blvd

2 WATER WELL OWNER: Mrs Lindgren
 RR#, St. Address, Box #: 1245 N River Blvd
 City, State, ZIP Code: Wichita Kansas 67203
 Board of Agriculture, Division of Water Resources
 Application Number: none

3 LOCATE WELL'S LOCATION WITH AN "X" IN SECTION BOX:

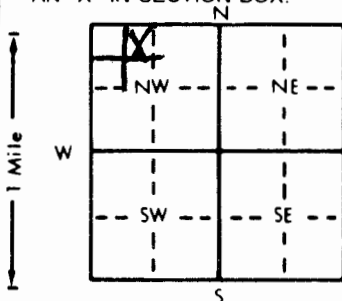

4 DEPTH OF COMPLETED WELL: 38 ft. ELEVATION: 7-27-94






WELL WATER TO BE USED AS: 5 Public water supply 8 Air conditioning 11 Injection well

1 Domestic 3 Feedlot 6 Oil field water supply 9 Dewatering 12 Other (Specify below)

2 Irrigation 4 Industrial 7 Lawn and garden only 10 Monitoring well

Was a chemical/bacteriological sample submitted to Department? Yes X No X; If yes, mo/day/yr sample was submitted

Water Well Disinfected? Yes X No X

5 TYPE OF BLANK CASING USED: 5 Wrought iron 8 Concrete tile CASING JOINTS: Glued X Clamped X

1 Steel 3 RMP (SR) 6 Asbestos-Cement 9 Other (specify below) Welded X

2 PVC 4 ABS 7 Fiberglass Threaded X

Blank casing diameter 5 in. to 28 ft. Dia 12 in. to 160 lbs./ft. Wall thickness or gauge No. 160

Casing height above land surface 12 in. weight 160 lbs./ft.

TYPE OF SCREEN OR PERFORATION MATERIAL: 7 PVC 10 Asbestos-cement

1 Steel 3 Stainless steel 5 Fiberglass 8 RMP (SR) 11 Other (specify)

2 Brass 4 Galvanized steel 6 Concrete tile 9 ABS 12 None used (open hole)

SCREEN OR PERFORATION OPENINGS ARE: 5 Gauzed wrapped 8 Saw cut 11 None (open hole)

1 Continuous slot 3 Mill slot 6 Wire wrapped 9 Drilled holes

2 Louvered shutter 4 Key punched 28 7 Torch cut 38 10 Other (specify)

SCREEN-PERFORATED INTERVALS: From 28 ft. to 38 ft. From 28 ft. to 38 ft.



6 GROUT MATERIAL: 1 Neat cement 12 Cement grout 3 Bentonite 4 Other

Grout Intervals: From 0 ft. to 18 ft. From 18 ft. to 38 ft.

What is the nearest source of possible contamination: 10 Livestock pens 14 Abandoned water well

1 Septic tank 4 Lateral lines 7 Pit privy 11 Fuel storage 15 Oil well/Gas well

2 Sewer lines 5 Cess pool 8 Sewage lagoon 12 Fertilizer storage 16 Other (specify below)

3 Watertight sewer lines 6 Seepage pit 9 Feedyard 13 Insecticide storage

Direction from well? South How many feet? 20

FROM TO LITHOLOGIC LOG FROM TO PLUGGING INTERVALS

0 8 Top Soil 0 8

8 20 Fine tan sand 8 20

20 38 Coarse tan sand 20 38

7 CONTRACTOR'S OR LANDOWNER'S CERTIFICATION: This water well was (1) constructed, (2) reconstructed, or (3) plugged under my jurisdiction and was completed on (mo/day/year) 7-27-94 and this record is true to the best of my knowledge and belief. Kansas Water Well Contractor's License No. 472 This Water Well Record was completed on (mo/day/yr) 7-27-94 under the business name of Barber Pump & Well Ser. by (signature) David R. Beck