

1 LOCATION OF WATER WELL:	Fraction	Section Number	Township Number	Range Number
County: <u>Sedgwick</u>	<u>SE</u> $\frac{1}{4}$ <u>SW</u> $\frac{1}{4}$ <u>SE</u> $\frac{1}{4}$	<u>29</u>	<u>T</u> <u>27</u> <u>S</u>	<u>R</u> <u>1</u> <u>EW</u>

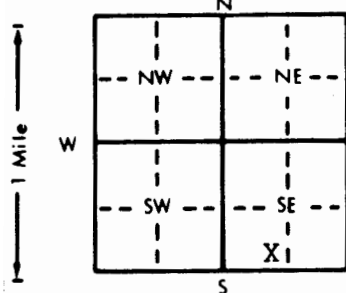
Distance and direction from nearest town or city street address of well if located within city?

Town & Country, 324 West Harry, Wichita, Kansas

2 WATER WELL OWNER:	<u>Town & Country Markets</u>	<u>01948031</u>	<u>MW-2</u>
RR#, St. Address, Box #:	<u>P.O. Box 17087</u>	<u>Board of Agriculture, Division of Water Resources</u>	
City, State, ZIP Code:	<u>Wichita, Kansas 67217</u>	Application Number:	

Approx. 1290.0

3 LOCATE WELL'S LOCATION WITH AN "X" IN SECTION BOX:	4 DEPTH OF COMPLETED WELL: <u>24.0</u> ft. ELEVATION: <u>Approx. 1290.0</u>
--	---

Depth(s) Groundwater Encountered 1. 19.0 ft. 2. 20.99 ft. 3. 10/05/94 ft.WELL'S STATIC WATER LEVEL 20.99 ft. below land surface measured on mo/day/yrPump test data: Well water was N/A ft. after 10/05/94 hours pumping gpmEst. Yield N/A gpm: Well water was N/A ft. after 10/05/94 hours pumping gpmBore Hole Diameter 8.25 in. to 24 ft., and 10/05/94 in. to 10/05/94 ft.

WELL WATER TO BE USED AS: 5 Public water supply 8 Air conditioning 11 Injection well

1 Domestic 3 Feedlot 6 Oil field water supply 9 Dewatering 12 Other (Specify below)

2 Irrigation 4 Industrial 7 Lawn and garden only 10 Monitoring wellWas a chemical/bacteriological sample submitted to Department? Yes No X If yes, mo/day/yr sample was submittedWater Well Disinfected? Yes No X

5 TYPE OF BLANK CASING USED:	5 Wrought iron	8 Concrete tile	CASING JOINTS: Glued <u>No</u> <u>X</u> Clamped <u>No</u> <u>X</u>
------------------------------	----------------	-----------------	--

1 Steel 3 RMP (SR) 6 Asbestos-Cement 9 Other (specify below) Welded No X2 PVC 4 ABS 7 Fiberglass Threaded No XBlank casing diameter 2 in. to 14 ft. Dia 2 in. to 14 ft. Dia 2 in. to 14 ft.Casing height above land surface -3 in. weight 14 lbs./ft. Wall thickness or gauge No. Schedule 40TYPE OF SCREEN OR PERFORATION MATERIAL: 7 PVC 10 Asbestos-cement

1 Steel 3 Stainless steel 5 Fiberglass 8 RMP (SR) 11 Other (specify)

2 Brass 4 Galvanized steel 6 Concrete tile 9 ABS 12 None used (open hole)

SCREEN OR PERFORATION OPENINGS ARE: 5 Gauzed wrapped 8 Saw cut 11 None (open hole)

1 Continuous slot 3 Mill slot 6 Wire wrapped 9 Drilled holes

2 Louvered shutter 4 Key punched 7 Torch cut 10 Other (specify)

SCREEN-PERFORATED INTERVALS: From 14 ft. to 24 ft. From 14 ft. to 24 ft.GRAVEL PACK INTERVALS: From 13 ft. to 24 ft. From 13 ft. to 24 ft.