


1 LOCATION OF WATER WELL:		Fraction		Section Number		Township Number		Range Number	
County:	Sedgwick	1/4	SE	1/4	NE	1/4	4	T 27 S	R 1 EW

2425 New York Ave, Wichita

3 LOCATE WELL'S LOCATION WITH AN "X" IN SECTION BOX: 4 DEPTH OF COMPLETED WELL.....24.6..... ft. ELEVATION:

Depth(s) Groundwater Encountered 1. ft. 2. ft. 3. ft.

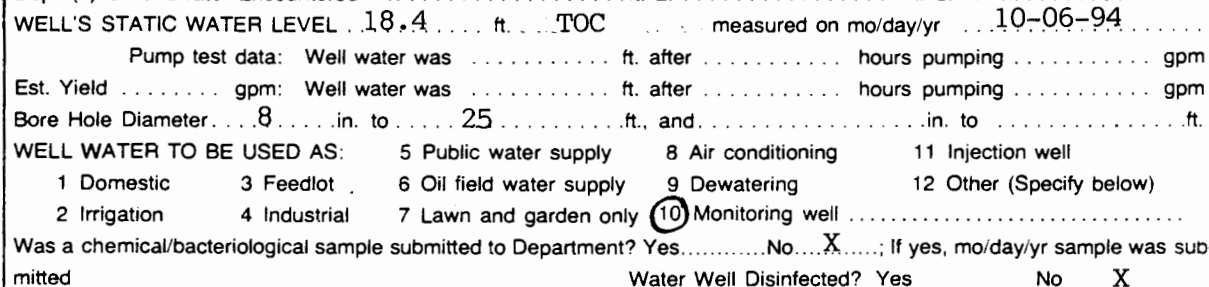

Blank casing diameter 2 in. to 14.6 ft., Dia in. to ft., Dia in. to ft.
Casing height above land surface 0 in. weight lbs./ft. Wall thickness or gauge No. sch. 40

SCREEN OR PERFORATION OPENINGS ARE:

1 Continuous slot	3 Mill slot	5 Gauzed wrapped	8 Saw cut	11 None (open hole)
2 Louvered shutter	4 Key punched	6 Wire wrapped	9 Drilled holes	
		7 Torch cut	10 Other (specify)	

GRAVEL PACK INTERVALS: From12.6..... ft. to25..... ft., From ft. to ft.
From ft. to ft., From ft. to ft.

What is the nearest source of possible contamination:			10 Livestock pens	14 Abandoned water well
1 Septic tank	4 Lateral lines	7 Pit privy	11 Fuel storage	15 Oil well/Gas well
2 Sewer lines	5 Cess pool	8 Sewage lagoon	12 Fertilizer storage	16 Other (specify below)
3 Watertight sewer lines	6 Seepage pit	9 Feedyard	13 Insecticide storage	Unknown

[illegible]

7 CONTRACTOR'S OR LANDOWNER'S CERTIFICATION: This water well was (1) constructed, (2) reconstructed, or (3) plugged under my jurisdiction and was completed on (mo/day/year) 10-03-94 and this record is true to the best of my knowledge and belief. Kansas Water Well Contractor's License No. 527 This Water Well Record was completed on (mo/day/yr) 10-31-94 under the business name of GeoCore Services, Inc. by (signature) Dale Holt