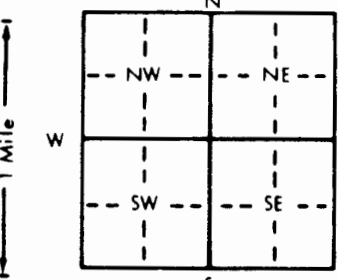


1 LOCATION OF WATER WELL: County: <u>26</u> Distance and direction from nearest town or city street address of well if located within city? <u>1632 FAIRVIEW</u>		WATER WELL RECORD Form WWC-5 KSA 82a-1212		Fraction <u>1/4</u>		Section Number <u>8</u>		Township Number T <u>27</u> S <u>1</u>		Range Number R <u>1</u> EAST			
2 WATER WELL OWNER: RR#, St. Address, Box # City, State, ZIP Code		THOMAS KEEHN 1632 FAIRVIEW WICHITA KS. 67203										Board of Agriculture, Division of Water Resources Application Number:	
3 LOCATE WELL'S LOCATION WITH AN "X" IN SECTION BOX: 		4 DEPTH OF COMPLETED WELL: <u>25</u> ft. ELEVATION: Depth(s) Groundwater Encountered 1. _____ ft. 2. _____ ft. 3. _____ ft. WELL'S STATIC WATER LEVEL <u>21</u> ft. below land surface measured on mo/day/yr Pump test data: Well water was _____ ft. after _____ hours pumping _____ gpm Est. Yield _____ gpm: Well water was _____ ft. after _____ hours pumping _____ gpm Bore Hole Diameter _____ in. to _____ ft., and _____ in. to _____ ft. WELL WATER TO BE USED AS: <input checked="" type="checkbox"/> Domestic 3 Feedlot 6 Oil field water supply 9 Dewatering 12 Other (Specify below) 2 Irrigation 4 Industrial 7 Lawn and garden only 10 Monitoring well Was a chemical/bacteriological sample submitted to Department? Yes _____ No <input checked="" type="checkbox"/> If yes, mo/day/yr sample was submitted _____ Water Well Disinfected? Yes <input checked="" type="checkbox"/> No _____											
5 TYPE OF BLANK CASING USED: <input checked="" type="checkbox"/> 1 Steel 3 RMP (SR) 2 PVC 4 ABS		5 Wrought iron 8 Concrete tile		CASING JOINTS: Glued _____ Clamped _____		6 Asbestos-Cement 9 Other (specify below)		Welded _____		Threaded <input checked="" type="checkbox"/>			
Blank casing diameter <u>5</u> in. to _____ ft., Dia _____ in. to _____ ft., Dia _____ in. to _____ ft.		Casing height above land surface <u>6</u> in., weight _____ lbs./ft. Wall thickness or gauge No. _____		TYPE OF SCREEN OR PERFORATION MATERIAL: 1 Steel 3 Stainless steel 5 Fiberglass 8 RMP (SR) 10 Asbestos-cement 2 Brass 4 Galvanized steel 6 Concrete tile 9 ABS 11 Other (specify) <u>NA</u> 12 None used (open hole)		SCREEN OR PERFORATION OPENINGS ARE: 1 Continuous slot 3 Mill slot 5 Gauzed wrapped 8 Saw cut 11 None (open hole) 2 Louvered shutter 4 Key punched 6 Wire wrapped 9 Drilled holes 10 Other (specify) <u>NA</u> 7 Torch cut		SCREEN-PERFORATED INTERVALS: From <u>NA</u> ft. to <u>NA</u> ft., From _____ ft. to _____ ft. From _____ ft. to _____ ft., From _____ ft. to _____ ft. GRAVEL PACK INTERVALS: From _____ ft. to _____ ft., From _____ ft. to _____ ft. From _____ ft. to _____ ft., From _____ ft. to _____ ft.					
6 GROUT MATERIAL: 1 Neat cement 2 Cement grout 3 Bentonite 4 Other		Grout Intervals: From <u>25</u> ft. to _____ ft., From _____ ft. to _____ ft., From _____ ft. to _____ ft.		What is the nearest source of possible contamination: 1 Septic tank 4 Lateral lines 7 Pit privy 10 Livestock pens 14 Abandoned water well 2 Sewer lines 5 Cess pool 8 Sewage lagoon 11 Fuel storage 15 Oil well/Gas well 3 Watertight sewer lines 6 Seepage pit 9 Feedyard 12 Fertilizer storage 16 Other (specify below) 13 Insecticide storage		Direction from well? <u>E</u> How many feet? <u>10</u>		FROM TO LITHOLOGIC LOG FROM TO PLUGGING INTERVALS <u>25'</u> <u>0'</u> <u>Cement</u>					
7 CONTRACTOR'S OR LANDOWNER'S CERTIFICATION: This water well was (1) constructed, (2) reconstructed, or (3) plugged under my jurisdiction and was completed on (mo/day/year) <u>11-19-94</u> and this record is true to the best of my knowledge and belief Kansas Water Well Contractor's License No. _____ This Water Well Record was completed on (mo/day/yr) _____ by (signature) <u>Thomas Keehn</u> under the business name of _____													
INSTRUCTIONS: Use typewriter or ball point pen. PLEASE PRESS FIRMLY and PRINT clearly. Please fill in blanks, underline or circle the correct answers. Send top three copies to Kansas Department of Health and Environment, Bureau of Water, Topeka, Kansas 66620-0001. Telephone: 913-296-5545. Send one to WATER WELL OWNER and retain one for your records.													