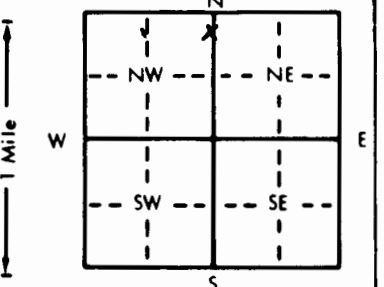


1 LOCATION OF WATER WELL: County: <u>SEDGWICK</u>		Fraction: <u>NE 1/4 NE 1/4 NW 1/4</u>	Section Number: <u>7</u>	Township Number: <u>T 27 S</u>	Range Number: <u>R 1 E</u>																														
Distance and direction from nearest town or city street address of well if located within city? <u>2005 W. 21ST ST., WICHITA, KS 67203</u>																																			
2 WATER WELL OWNER: <u>COASTAL MART INC.</u> RR#, St. Address, Box #: <u>9 GREENWAY PLAZA</u> City, State, ZIP Code: <u>HOUSTON, TX 77046</u>			Board of Agriculture, Division of Water Resources Application Number:																																
3 LOCATE WELL'S LOCATION WITH AN "X" IN SECTION BOX: 		4 DEPTH OF COMPLETED WELL: <u>26.5</u> ft. ELEVATION: Depth(s) Groundwater Encountered 1. <u>20.6</u> ft. 2. ft. 3. ft. WELL'S STATIC WATER LEVEL <u>20</u> ft. below land surface measured on mo/day/yr Pump test data: Well water was ft. after hours pumping gpm Est. Yield gpm: Well water was ft. after hours pumping gpm Bore Hole Diameter: <u>8</u> in. to ft., and in. to ft. WELL WATER TO BE USED AS: 1 Domestic 3 Feedlot 6 Oil field water supply 9 Dewatering 12 Other (Specify below) 2 Irrigation 4 Industrial 7 Lawn and garden only <u>10 Monitoring well</u> Was a chemical/bacteriological sample submitted to Department? Yes No <u>X</u> ; If yes, mo/day/yr sample was submitted Water Well Disinfected? Yes No <u>X</u>																																	
5 TYPE OF BLANK CASING USED: 1 Steel 3 RMP (SR) 5 Wrought iron 8 Concrete tile CASING JOINTS: Glued Clamped <u>2 PVC</u> 4 ABS 6 Asbestos-Cement 9 Other (specify below) Welded Blank casing diameter <u>2</u> in. to ft., Dia. in. to ft., Dia. <u>Threaded</u> <u>FLUSH</u> Casing height above land surface: <u>FLUSH</u> in., weight <u>703</u> lbs./ft. Wall thickness or gauge No. <u>154</u> TYPE OF SCREEN OR PERFORATION MATERIAL: 1 Steel 3 Stainless steel 5 Fiberglass 8 RMP (SR) 10 Asbestos-cement 2 Brass 4 Galvanized steel 6 Concrete tile 9 ABS 11 Other (specify) SCREEN OR PERFORATION OPENINGS ARE: 1 Continuous slot <u>3 Mill slot</u> 5 Gauzed wrapped 8 Saw cut 11 None (open hole) 2 Louvered shutter 4 Key punched 6 Wire wrapped 9 Drilled holes 7 Torch cut 10 Other (specify) SCREEN-PERFORATED INTERVALS: From <u>16.5</u> ft. to <u>26.5</u> ft., From ft. to ft. GRAVEL PACK INTERVALS: From <u>14.5</u> ft. to <u>26.5</u> ft., From ft. to ft. From ft. to ft., From ft. to ft.																																			
6 GROUT MATERIAL: 1 Neat cement 2 Cement grout <u>3 Bentonite</u> 4 Other Grout Intervals: From <u>14.5</u> ft. to <u>1</u> ft., From ft. to ft., From ft. to ft. What is the nearest source of possible contamination: 1 Septic tank 4 Lateral lines 7 Pit privy <u>11 Fuel storage</u> 14 Abandoned water well 2 Sewer lines 5 Cess pool 8 Sewage lagoon 12 Fertilizer storage 15 Oil well/Gas well 3 Watertight sewer lines 6 Seepage pit 9 Feedyard 13 Insecticide storage 16 Other (specify below) Direction from well? <u>NORTHEAST</u> How many feet? <u>225</u>																																			
<table border="1"><thead><tr><th>FROM</th><th>TO</th><th>LITHOLOGIC LOG</th><th>FROM</th><th>TO</th><th>PLUGGING INTERVALS</th></tr></thead><tbody><tr><td><u>0.5</u></td><td><u>12.0</u></td><td><u>SAND</u></td><td></td><td></td><td></td></tr><tr><td><u>12.0</u></td><td><u>18.0</u></td><td><u>SAND, CLAYEY</u></td><td></td><td></td><td></td></tr><tr><td><u>18.0</u></td><td><u>20.0</u></td><td><u>SAND</u></td><td></td><td></td><td></td></tr><tr><td><u>20.0</u></td><td><u>26.5</u></td><td><u>SAND, GRAVEL</u></td><td></td><td></td><td></td></tr>
7 CONTRACTOR'S OR LANDOWNER'S CERTIFICATION: This water well was (1) constructed, (2) reconstructed, or (3) plugged under my jurisdiction and was completed on (mo/day/year) <u>5/2/95</u> and this record is true to the best of my knowledge and belief. Kansas Water Well Contractor's License No. <u>531</u> This Water Well Record was completed on (mo/day/yr) <u>5/5/95</u> under the business name of <u>GSI</u> by (signature) <u>Steve Nudler</u>																																			