

Corrected

WATER WELL PLUGGING RECORD Form WWC-5P

KSA 82a-1212

ID NO.

No. ~~Well~~ Number 3

B-30

1 LOCATION OF WATER WELL: County: Neosho	Fraction NW ¼ SW¼ SE ¼ SE ¼	Section Number 13	Township Number 27 T S	Range Number 17 <input type="checkbox"/> E <input type="checkbox"/> W
--	---------------------------------------	-----------------------------	----------------------------------	---

Street/Rural Address of Well Location; if unknown, distance & direction from nearest town or intersection: If at owner's address, check here ☒ **1801 N Santa Fe Chanute, Kansas 66720**

Global Positioning Systems (GPS) information:

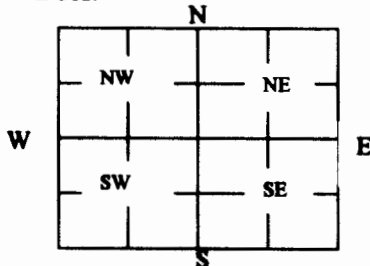
Latitude: **37.69077** (in decimal degrees)Longitude: **95.49282** (in decimal degrees)Elevation: **933**Datum: ☐ WGS84, ☒ NAD83, ☐ NAD27

Collection Method:

☒ GPS unit (Make/Model: **Garman Etrex 20**)☐ Digital Map/Photo, ☐ Topographic Map, ☐ Land SurveyEst. Accuracy: ☐ < 3 m, ☐ 3-5 m, ☒ 5-15 m, ☐ > 15 m

2 WATER WELL OWNER: **Ash Grove Cement RR#, St. Address, Box #: 1801 N Santa Fe City, State ZIP Code: Chanute Kansas 66720**

3 MARK WELL'S LOCATION WITH AN "X" IN SECTION BOX:

4 DEPTH OF WELL **12.5** ft.WELL'S STATIC WATER LEVEL **10** ft

WELL WAS USED AS:

☐ Domestic
☐ Irrigation
☐ Feedlot
☐ Industrial

☐ Public Water Supply
☐ Oil Field Water Supply
☐ Domestic (Lawn & Garden)
☐ Air Conditioning

☐ Dewatering
☒ Monitoring
☐ Injection Well
☐ Other
Was a chemical/bacteriological sample submitted to Department? Yes ☐ No ☒

5 TYPE OF BLANK CASING USED:

☐ Steel
☒ PVC

☐ RMP (SR)
☐ ABS

☐ Wrought
☐ Asbestos-Cement

☐ Fiberglass
☐ Concrete Tile
☐ Other (Specify below) _____

Blank casing diameter **2** in. Was casing pulled? Yes ☐ No ☒ If yes, how much _____
 Casing height above or below land surface **36** in.

6 GROUT PLUG MATERIAL: ☐ Neat cement ☐ Cement grout ☒ Bentonite ☐ Other _____Grout Plug Intervals: From **12.5** ft. to **3** ft., From **3** ft. to **0** ft., From _____ ft. to _____ ft.

What is the nearest source of possible contamination:

☐ Septic tank
☐ Sewer lines
☐ Watertight sewer lines
☐ Lateral lines
☐ Cess pool

☐ Seepage pit
☐ Pit privy
☐ Sewage lagoon
☐ Feedyard
☐ Livestock pens

☐ Fuel storage
☐ Fertilizer storage
☐ Insecticide storage
☐ Abandoned water well
☐ Oil well/Gas well

☒ Other (specify below)
Ash Groves Landfill

Direction from well? **n**
 How many feet? **100**

FROM	TO	PLUGGING MATERIALS	FROM	TO	PLUGGING MATERIALS

7 CONTRACTOR'S OR LANDOWNER'S CERTIFICATION: This water well was plugged under my jurisdiction and was completed on (mo/day/year) **06/11/2018** and this record is true to the best of my knowledge and belief. Kansas Water Well Contractor's License No. **529**. This Water Well Record was completed on (mo/day/year) **06/13/2018** under the business name of **Geotechnology** by (signature) _____

Send one white copy to Kansas Department of Health & Environment, Geology Section, 1000 SW Jackson Street, Ste. 420, Topeka, KS 66612-1367. Send one copy to WATER WELL OWNER and retain one for your records.

Visit us at <http://www.kdheks.gov/waterwell/index.html> Telephone 785-296-5524.

KSA82a-1212

Revised 1/29/2014