

CORRECTION(S) TO WATER WELL RECORD (WWC-5)

(to rectify lacking or incorrect information)

County: Neosho

Location listed as:

Section-Township-Range: 16 - 26S - 17E

Fraction ($\frac{1}{4}$ $\frac{1}{4}$ $\frac{1}{4}$): NW SW SW

Location changed to:

16 - 27S - 18E

NW SW SW

Other changes: Initial statements: _____

Changed to: _____

Comments: _____

verification method: Online mapping service, Neosho County map, and address


given by driller

initials: JB date: 10-19-04

1	LOCATION OF WATER WELL:	Fraction	Section Number	Township Number	Range Number
County:	<u>NEOSHO</u>	<u>NW 1/4 SW 1/4 SW 1/4</u>	<u>16</u>	<u>26 S</u>	<u>17 E</u>

Distance and direction from nearest town or city street address of well if located within city?
1125 N. SANTA FE CHANUTE, KS

2	WATER WELL OWNER:	<u>ATOFINA PETROCHEMICALS, INC.</u>		<u>ATTN: JOHN WETHUNT</u>
RR #, St. Address, Box #:	<u>15710 JFK BLVD,</u>	Board of Agriculture, Division of Water Resources		
City, State, ZIP Code :	<u>P.O. Box 67441</u>	Application Number:		
	<u>HOUSTON, TX 77267-4411</u>			

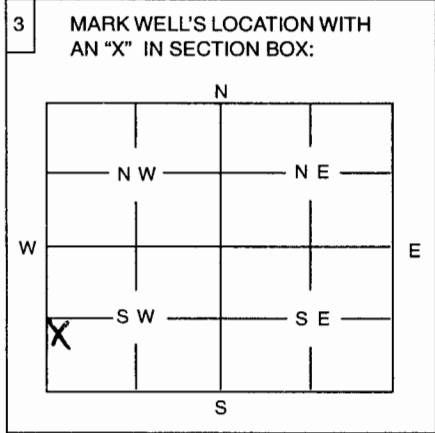

4 DEPTH OF WELL 11.95 ft

WELL'S STATIC WATER LEVEL 2.75 ft.

WELL WAS USED AS:

1 Domestic	5 Public Water Supply	9 Dewatering
2 Irrigation	6 Oil Field Water Supply	<input checked="" type="checkbox"/> 10 Monitoring Well
3 Feedlot	7 Domestic (Lawn & Garden)	11 Injection Well
4 Industrial	8 Air Conditioning	12 Other

Was a chemical / bacteriological sample submitted to Department? Yes No

If yes, mo/day/yr sample was submitted

Water Well Disinfected: Yes No

5 TYPE OF BLANK CASING USED:

1 Steel	3 RMP (SR)	5 Wrought	7 Fiberglass	9 Other (Specify below)
<input checked="" type="checkbox"/> 2 PVC	4 ABS	6 Asbestos-Cement	8 Concrete Tile	

Blank casing diameter 2 in. Was casing pulled? Yes No If yes, how much 11.95'

Casing height above or below land surface 0 in.

6 GROUT PLUG MATERIAL: 1 Neat cement 2 Cement grout Bentonite 4 Other

Grout Plug Intervals: From 11.95 ft. to 3 ft., From ft. to ft., From to ft.

What is the nearest source of possible contamination:

1 Septic tank	6 Seepage pit	11 Fuel storage	16 Other (specify below)
2 Sewer lines	7 Pit privy	12 Fertilizer storage	
3 Watertight sewer lines	8 Sewage lagoon	13 Insecticide storage	
4 Lateral lines	9 Feedyard	14 Abandoned water well	
5 Cess Pool	10 Livestock pens	15 Oil well/Gas well	

Direction from well? How many feet?

FROM	TO	PLUGGING MATERIALS

RECEIVED
 SEP 22 2004
 DIVISION OF WATER

7 CONTRACTOR'S OR LANDOWNER'S CERTIFICATION: This water well was plugged under my jurisdiction and was completed on (mo/day/year) 8-11-04 and this record is true to the best of my knowledge and belief. Kansas Water Well Contractor's License No. 529 This Water Well Record was completed on (mo/day/year) 8/26/2004 under the business name of GEOTECHNOLOGY, INC by (signature) [Signature]

INSTRUCTIONS: Use typewriter or ball point pen. Please press firmly and print clearly. Please fill in blanks, underline or circle the correct answers. Send top three copies to Kansas Department of Health and Environment, Bureau of Water, Topeka, Kansas 66620-0001. Telephone: 785/296-3565. Send one to Water Well Owner and retain one for your records.