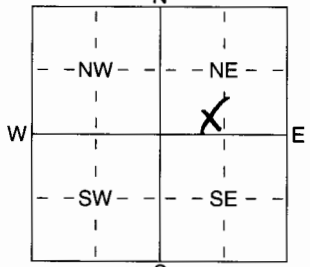


1 LOCATION OF WATER WELL: Fraction SE 1/4 SW 1/4 NE 1/4 Section Number 28 Township Number T 27 S Range Number R 18 EW  
 County: Neosho

Distance and direction from nearest town or city street address of well if located within city?  
Next to the City of Chanute Public Works facility on 14th St and S. Katy Ave.

2 WATER WELL OWNER: Conoco Phillips  
 RR#, St. Address, Box # : 1234 Phillips Bldg Board of Agriculture, Division of Water Resources  
 City, State, ZIP Code : Chanute, OK 74004 Application Number:

3 LOCATE WELL'S LOCATION WITH AN "X" IN SECTION BOX:  
  
 4 DEPTH OF COMPLETED WELL 20 ft. ELEVATION:  
 Depth(s) Groundwater Encountered 1 10.41 ft. 2 — ft. 3 — ft.  
 WELL'S STATIC WATER LEVEL 10.41 ft. below land surface measured on mo/day/yr 10/12/05  
 Pump test data: Well water was — ft. after — hours pumping — gpm  
 Est. Yield — gpm: Well water was — ft. after — hours pumping — gpm  
 WELL WATER TO BE USED AS:  
 5 Public water supply 8 Air conditioning 11 Injection well  
 1 Domestic 3 Feedlot 6 Oil field water supply 9 Dewatering 12 Other (Specify below)  
 2 Irrigation 4 Industrial 7 Domestic (lawn & garden) 10 Monitoring well  
 Was a chemical/bacteriological sample submitted to Department? Yes — No X; If yes, mo/day/yr sample was submitted  
 Water Well Disinfected? Yes — No X

5 TYPE OF BLANK CASING USED:  
 1 Steel 3 RMP (SR) 5 Wrought iron 8 Concrete tile CASING JOINTS: Glued — Clamped —  
2 PVC 4 ABS 6 Asbestos-Cement 9 Other (specify below) Welded —  
 7 Fiberglass Threaded X  
 Blank casing diameter 1 in. to 10 ft., Dia — in. to — ft., Dia — in. to — ft.  
 Casing height above land surface 30 in., weight — lbs./ft. Wall thickness or gauge No. EL. 70  
 TYPE OF SCREEN OR PERFORATION MATERIAL:  
 1 Steel 3 Stainless Steel 5 Fiberglass 7 PVC 10 Asbestos-Cement  
 2 Brass 4 Galvanized Steel 6 Concrete tile 8 RMP (SR) 11 Other (Specify) —  
 9 ABS 12 None used (open hole)  
 SCREEN OR PERFORATION OPENINGS ARE:  
 1 Continuous slot 3 Mill slot 5 Gauzed wrapped 8 Saw cut 11 None (open hole)  
 2 Louvered shutter 4 Key punched 6 Wire wrapped 9 Drilled holes  
 7 Torch cut 10 Other (specify) — ft.  
 SCREEN-PERFORATED INTERVALS: From 10 ft. to 20 ft., From — ft. to — ft.  
 From — ft. to — ft., From — ft. to — ft.  
 GRAVEL PACK INTERVALS: From 8 ft. to 20 ft., From — ft. to — ft.  
 From — ft. to — ft., From — ft. to — ft.

6 GROUT MATERIAL: 1 Neat cement 2 Cement grout 3 Bentonite 4 Other —  
 Grout Intervals: From 2 ft. to 8 ft., From — ft. to — ft., From — ft. to — ft.  
 What is the nearest source of possible contamination:  
 1 Septic tank 4 Lateral lines 7 Pit privy 10 Livestock pens 14 Abandoned water well  
 2 Sewer lines 5 Cess pool 8 Sewage lagoon 11 Fuel storage 15 Oil well/Gas well  
 3 Watertight sewer lines 6 Seepage pit 9 Feedyard 12 Fertilizer storage 16 Other (specify below)  
Former Refinery  
 Direction from well? — How many feet? —

FROM	TO	LITHOLOGIC LOG	FROM	TO	PLUGGING INTERVALS
<u>0</u>	<u>20</u>	<u>Silty clay</u>			

7 CONTRACTOR'S OR LANDOWNER'S CERTIFICATION: This water well was 1 constructed, (2) reconstructed, or (3) plugged under my jurisdiction and was completed on (mo/day/year) 10/11/05 and this record is true to the best of my knowledge and belief. Kansas Water Well Contractor's Licence No 710 This Water Well Record was completed on (mo/day/yr) 10/11/05 under the business name of Below Ground Surface, Inc. by (signature) [Signature]