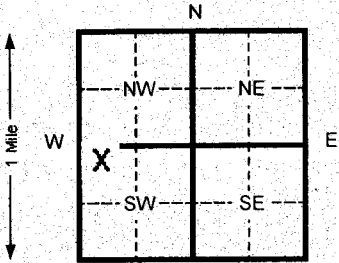


1 LOCATION OF WATER WELL: County: **Neosho** Fraction: **NW 1/4 NW 1/4 SW 1/4** Section Number: **28** Township Number: **T 27S S** Range Number: **R 18E W**

Distance and direction from nearest town or city street address of well if located within city?  
**1422 S. Santa Fe, Chanute, Kansas**

2 WATER WELL OWNER: **No Mug LLC**  
 RR#, St. Address, Box #: **2110 S. Santa Fe**  
 City, State, ZIP Code: **Chanute, Ks**  
 Board of Agriculture, Division of Water Resources  
 Application Number:

3 LOCATE WELL'S LOCATION WITH AN "X" IN SECTION BOX:  

 4 DEPTH OF COMPLETED WELL: **15** ft. ELEVATION:  
 Depth(s) Groundwater Encountered **11.5** ft. **2** ft. **3** ft. Ft.  
 WELL'S STATIC WATER LEVEL: **2.42** ft. below land surface measured on **09/17/08**  
 Pump test data: Well water was \_\_\_\_\_ Ft. after \_\_\_\_\_ hours pumping \_\_\_\_\_ Gpm  
 Est. Yield \_\_\_\_\_ Gpm: Well water was \_\_\_\_\_ Ft. after \_\_\_\_\_ Hours pumping \_\_\_\_\_ Gpm  
 Bore Hole Diameter: **8.625** in. to **15** ft. and \_\_\_\_\_ in. to \_\_\_\_\_ Ft.  
 WELL WATER TO BE USED AS:  
 5 Public water supply 8 Air conditioning 11 Injection well  
 1 Domestic 3 Feed lot 6 Oil field water supply 9 Dewatering 12 Other (Specify below)  
 2 Irrigation 4 Industrial 7 Lawn and garden (domestic) 10 **Monitoring well** **MW-3**  
 Was a chemical/bacteriological sample submitted to Department? Yes  No  If yes, mo/day/yr sample was Submitted \_\_\_\_\_  
 Water Well Disinfected? Yes \_\_\_\_\_ No

5 TYPE OF BLANK CASING USED:  
 1 Steel 3 RMP (SR) 5 Wrought Iron 8 Concrete tile CASING JOINTS: Glued \_\_\_\_\_ Clamped \_\_\_\_\_  
 2 **PVC** 4 ABS 6 Asbestos-Cement 9 Other (specify below) \_\_\_\_\_ Welded \_\_\_\_\_  
 7 Fiberglass \_\_\_\_\_ **Threaded** **X**  
 Blank casing diameter **2** in. to **5** Ft. Dia \_\_\_\_\_ in. to \_\_\_\_\_ ft. Dia \_\_\_\_\_ in. to \_\_\_\_\_ ft.  
 Casing height above land surface **FLUSH** in., weight **SCH 40** Lbs./ft. Wall thickness or gauge No. \_\_\_\_\_  
 TYPE OF SCREEN OR PERFORATION MATERIAL:  
 1 Steel 3 Stainless steel 5 Fiberglass 7 **PVC** 10 Asbestos-cement  
 2 Brass 4 Galvanized steel 6 Concrete tile 8 RMP (SR) 11 Other (specify) \_\_\_\_\_  
 9 ABS 12 None used (open hole) \_\_\_\_\_  
 SCREEN OR PERFORATION OPENINGS ARE:  
 1 Continuous slot 3 **Mill slot** 5 Gauzed wrapped 8 Saw cut 11 None (open hole)  
 2 Louvered shutter 4 Key punched 6 Wire wrapped 9 Drilled holes  
 7 Torch cut 10 Other (specify) \_\_\_\_\_  
 SCREEN-PERFORATED INTERVALS: From **5** ft. to **15** ft. From \_\_\_\_\_ ft. to \_\_\_\_\_ ft.  
 SAND PACK INTERVALS: From **4** ft. to **15** ft. From \_\_\_\_\_ ft. to \_\_\_\_\_ ft.  
 From \_\_\_\_\_ ft. to \_\_\_\_\_ ft. From \_\_\_\_\_ ft. to \_\_\_\_\_ ft.

6 GROUT MATERIAL: 1 Neat cement 2 **Cement grout** 3 **Bentonite** 4 Other \_\_\_\_\_  
 Grout Intervals From **3** **0** ft. to **2** Ft. From **2** to **4** ft. From \_\_\_\_\_ ft. to \_\_\_\_\_ ft.  
 What is the nearest source of possible contamination:  
 1 Septic tank 4 Lateral lines 7 Pit privy 10 Livestock pens 14 Abandoned water well  
 2 Sewer lines 5 Cess pool 8 Sewage lagoon 11 Fuel storage 15 Oil well/ Gas well  
 3 Watertight sewer lines 6 Seepage pit 9 Feedyard 12 Fertilizer storage 16 **Other (specify below)**  
**Contaminated Site**  
 Direction from well? \_\_\_\_\_ How many feet? \_\_\_\_\_

FROM	TO	CODE	LITHOLOGIC LOG	FROM	TO	PLUGGING INTERVALS
0	1		Gravel pack			
1	3		Clay, black			
3	15		Siltstone, Brown			
15	TD		End of Borehole			

7 CONTRACTOR'S OR LANDOWNER'S CERTIFICATION: This water well was (x) constructed, (2) reconstructed, or (3) plugged under my jurisdiction and Completed on (mo/day/yr) **09/17/08** And this record is true to the best of my knowledge and belief. Kansas  
 Water Well Contractor's License No. **585** This Water Well Record was completed on (mo/day/yr) **10/17/08**  
 under the business name of **Associated Environmental, Inc.** By (signature) **Bradley J. Johnson**

INSTRUCTIONS: Please fill in blanks and circle the correct answers. Send three copies to Kansas Department of Health and Environment, Bureau of Water, Topeka, Kansas 66620-0001. Telephone: 913-296-5545. Send one to WATER WELL OWNER and retain one for your records.

OFFICE USE ONLY

T

R

SEC