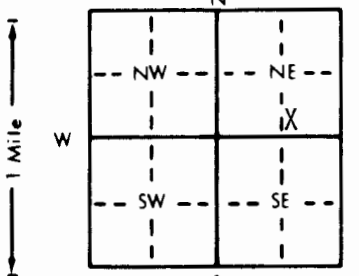


1 LOCATION OF WATER WELL:		Fraction	Section Number	Township Number	Range Number
County: <u>Neosho</u>		<u>SW</u> $\frac{1}{4}$ <u>SE</u> $\frac{1}{4}$ <u>NE</u> $\frac{1}{4}$	<u>20</u>	<u>T</u> <u>27</u> <u>S</u>	<u>R</u> <u>18</u> <u>E/W</u>
Distance and direction from nearest town or city street address of well if located within city? <u>Approx. 140 NW of SE corner of 202 W. Main Street, Chanute, Kansas</u>					
2 WATER WELL OWNER: <u>Crescent Oil</u>					
RR#, St. Address, Box # : <u>202 W. Main Street</u>					
City, State, ZIP Code : <u>Chanute, Kansas 66720</u>					
Board of Agriculture, Division of Water Resources Application Number:					
3 LOCATE WELL'S LOCATION WITH AN "X" IN SECTION BOX:		4 DEPTH OF COMPLETED WELL <u>12.4</u> ft. ELEVATION: <u>9.0</u> ft.			
		Depth(s) Groundwater Encountered <u>1</u> ft. <u>9.0</u> ft. 2. ft. 3. ft.			
		WELL'S STATIC WATER LEVEL <u>9.0</u> ft. below land surface measured on mo/day/yr			
		Pump test data: Well water was ft. after hours pumping gpm			
		Est. Yield gpm: Well water was ft. after hours pumping gpm			
		Bore Hole Diameter <u>6</u> in. to <u>14.5</u> in. to ft.			
		WELL WATER TO BE USED AS: 5 Public water supply 8 Air conditioning 11 Injection well			
		1 Domestic 3 Feedlot 6 Oil field water supply 9 Dewatering 12 Other (Specify below)			
		2 Irrigation 4 Industrial 7 Lawn and garden only <u>10 Monitoring well</u>			
		Was a chemical/bacteriological sample submitted to Department? Yes No <u>X</u> ; If yes, mo/day/yr sample was submitted			
		Water Well Disinfected? Yes No <u>X</u>			
5 TYPE OF BLANK CASING USED:					
1 Steel 3 RMP (SR) 5 Wrought iron 8 Concrete tile CASING JOINTS: Glued Clamped					
2 <u>PVC</u> 4 ABS 6 Asbestos-Cement 9 Other (specify below) Welded					
7 Fiberglass Threaded <u>X</u>					
Blank casing diameter <u>2</u> in. to <u>3.5</u> ft. Dia. <u>Sch 40</u> in. to ft. Dia. in. to ft.					
Casing height above land surface <u>0.0</u> in., weight <u>Sch 40</u> lbs./ft. Wall thickness or gauge No.					
TYPE OF SCREEN OR PERFORATION MATERIAL:					
1 Steel 3 Stainless steel 5 Fiberglass 8 RMP (SR) 10 Asbestos-cement					
2 Brass 4 Galvanized steel 6 Concrete tile 9 ABS 11 Other (specify)					
12 None used (open hole)					
SCREEN OR PERFORATION OPENINGS ARE:					
1 Continuous slot 3 <u>Mill slot</u> 5 Gauzed wrapped 8 Saw cut 11 None (open hole)					
2 Louvered shutter 4 Key punched 6 Wire wrapped 9 Drilled holes					
7 Torch cut 10 Other (specify)					
SCREEN-PERFORATED INTERVALS: From <u>3.5</u> ft. to <u>12.4</u> ft. From ft. to ft.					
From ft. to ft. From ft. to ft.					
GRAVEL PACK INTERVALS: From <u>3.0</u> ft. to <u>14.5</u> ft. From ft. to ft.					
From ft. to ft. From ft. to ft.					
6 GROUT MATERIAL: 1 Neat cement 2 <u>Cement grout</u> 3 Bentonite 4 Other					
Grout Intervals: From <u>0.0</u> ft. to <u>3.0</u> ft. From ft. to ft. From ft. to ft.					
What is the nearest source of possible contamination:					
1 Septic tank 4 Lateral lines 7 Pit privy 10 Livestock pens 14 Abandoned water well					
2 Sewer lines 5 Cess pool 8 Sewage lagoon 11 Fuel storage 15 Oil well/Gas well					
3 Watertight sewer lines 6 Seepage pit 9 Feedyard 12 Fertilizer storage 16 Other (specify below)					
13 Insecticide storage					
Direction from well? How many feet?					
FROM	TO	LITHOLOGIC LOG	FROM	TO	PLUGGING INTERVALS
0.0	0.1	F LS Gr			
0.1	0.6	F Gw Sw			
0.6	1.5	Dk Gr sa Ln Cl w/Gr tr organics			
1.5	2.0	Concrete & Brick, rubble			
2.0	2.5	Dk Gr sa Ln Cl Tr organics			
2.5	3.0	Olive Gr L-F Cl w/ ine sa			
3.0	4.5	Org Br Si F Sa			
4.5	8.0	Org Br slightly weathered sandstone			
8.0	14.5	Gr Br sandstone			
7 CONTRACTOR'S OR LANDOWNER'S CERTIFICATION: This water well was <u>(1)</u> constructed, (2) reconstructed, or (3) plugged under my jurisdiction and was completed on (mo/day/year) <u>2/4/92</u> and this record is true to the best of my knowledge and belief. Kansas Water Well Contractor's License No. <u>416</u> This Water Well Record was completed on (mo/day/yr) <u>2/4/92</u> under the business name of <u>Terracon Consultants SE, Inc.</u> by (signature) <u>[Signature]</u>					