


1 LOCATION OF WATER WELL: County: Neosho Fraction: NE 1/4 SW 1/4 SE 1/4 Section Number: 27 Township Number: T 27 S Range Number: R 18 E

Distance and direction from nearest town or city street address of well if located within city?  
1 1/4 miles east and 1/4 mile south on 14th St, Chanute KS

2 WATER WELL OWNER: Castle & Associates BH-1  
 RR#, St. Address, Box #: 3000 W. Kellogg, Suite 209 Board of Agriculture, Division of Water Resources  
 City, State, ZIP Code: Wichita, KS 67209 Application Number:

3 LOCATE WELL'S LOCATION WITH AN "X" IN SECTION BOX:

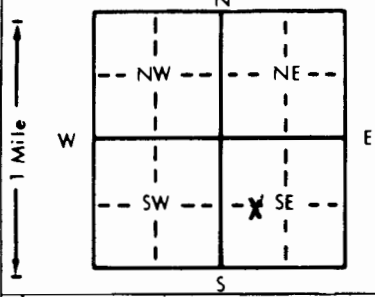

4 DEPTH OF COMPLETED WELL: 24 ft. ELEVATION:  
 Depth(s) Groundwater Encountered 1. 21 ft. 2. ft. 3. ft.  
 WELL'S STATIC WATER LEVEL: 21 ft. below land surface measured on mo/day/yr 4-25-89  
 Pump test data: Well water was ft. after hours pumping gpm  
 Est. Yield gpm: Well water was ft. after hours pumping gpm  
 Bore Hole Diameter: 8 in. to 24 ft., and in. to ft.  
 WELL WATER TO BE USED AS:  
 5 Public water supply 8 Air conditioning 11 Injection well  
 1 Domestic 3 Feedlot 6 Oil field water supply 9 Dewatering 12 Other (Specify below)  
 2 Irrigation 4 Industrial 7 Lawn and garden only 10 Monitoring well Water Sampling  
 Was a chemical/bacteriological sample submitted to Department? Yes.....No...X..... If yes, mo/day/yr sample was submitted  
 Water Well Disinfected? Yes No X

5 TYPE OF BLANK CASING USED:  
 1 Steel 3 RMP (SR) 5 Wrought iron 8 Concrete tile CASING JOINTS: Glued.....Clamped.....  
2 PVC 4 ABS 6 Asbestos-Cement 9 Other (specify below) Welded.....  
 Blank casing diameter: 2 in. to 19 ft., Dia. in. to ft., Dia. in. to ft.  
 Casing height above land surface: 12 in., weight lbs./ft. Wall thickness or gauge No. 44 40  
 TYPE OF SCREEN OR PERFORATION MATERIAL:  
 1 Steel 3 Stainless steel 5 Fiberglass 8 RMP (SR) 10 Asbestos-cement  
 2 Brass 4 Galvanized steel 6 Concrete tile 9 ABS 11 Other (specify).....  
 SCREEN OR PERFORATION OPENINGS ARE:  
 1 Continuous slot 3 Mill slot 5 Gauzed wrapped 8 Saw cut 11 None (open hole)  
 2 Louvered shutter 4 Key punched 6 Wire wrapped 9 Drilled holes  
 7 Torch cut 10 Other (specify).....

SCREEN-PERFORATED INTERVALS: From 19 ft. to 24 ft., From ft. to ft.  
 GRAVEL PACK INTERVALS: From ft. to ft., From ft. to ft.  
 FROM ft. TO ft. FROM ft. TO ft. FROM ft. TO ft. FROM ft. TO ft.

6 GROUT MATERIAL: 1 Neat cement 2 Cement grout 3 Bentonite 4 Other  
 Grout intervals: From surface ft. to 24 ft., From ft. to ft., From ft. to ft.  
 What is the nearest source of possible contamination:  
 1 Septic tank 4 Lateral lines 7 Pit privy 10 Livestock pens 14 Abandoned water well  
 2 Sewer lines 5 Cess pool 8 Sewage lagoon 11 Fuel storage 15 Oil well/Gas well  
 3 Watertight sewer lines 6 Seepage pit 9 Feedyard 12 Fertilizer storage 16 Other (specify below)  
 13 Insecticide storage  
 Direction from well? How many feet?

FROM	TO	LITHOLOGIC LOG	FROM	TO	PLUGGING INTERVALS
0	15	Brown, silty CLAY			
15	21	Lt brown, silty, med to fine grained SAND			
21	24	Same as above w/ gravel			
Bore hole drilled and plugged on 4-25-89					

7 CONTRACTOR'S OR LANDOWNER'S CERTIFICATION: This water well was (1) constructed, (2) reconstructed, or (3) plugged under my jurisdiction and was completed on (mo/day/year) 4-25-89 and this record is true to the best of my knowledge and belief. Kansas Water Well Contractor's License No. 496 This Water Well Record was completed on (mo/day/yr) 5-25-89 under the business name of Groundwater Technology Inc by (signature) David Lee

INSTRUCTIONS: Use typewriter or ball point pen. PLEASE PRESS FIRMLY and PRINT clearly. Please fill in blanks, underline or circle the correct answers. Send top three copies to Kansas Department of Health and Environment, Bureau of Water Protection, Topeka, Kansas 66620-7320. Telephone: 913-296-5514. Send one to WATER WELL OWNER and retain one for your records.

OFFICE USE ONLY  
T  
R  
EW  
SEC.