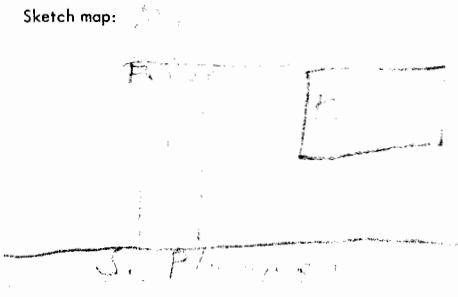


USE TYPEWRITER OR BALL POINT PEN-PRESS FIRMLY, PRINT CLEARLY.

WATER WELL RECORD
KSA 82a-1201-1215

T R EW sec 1/4 1/4 1/4 No.

Kansas State Dept. Of Health
(Water Well Contractors)
Forbes-Bldg. 740
Topeka, Kansas 66620

1 Location of well:	County Neosho	Township name Tioga	Fraction NE SW	Section number 30	Town number 27	Range number 18 E																																
Distance and direction from nearest town or city: Street address of well location if in city: 1001 South Plummer				3 Owner of well: Lyle H. Kensinger Address: 1001 South Plummer Chanute, KS 66720																																		
Locate with "X" in section below: N W E S 1 Mile				Sketch map: 		4 Well depth: 128 ft. Date of completion: 4-1-76 Well diameter: 8 in.																																
<table border="1" style="width:100%; border-collapse: collapse;"> <thead> <tr> <th style="width:50%;">2 Type and color of material</th> <th style="width:10%;">From</th> <th style="width:10%;">To</th> </tr> </thead> <tbody> <tr><td>black dirt</td><td>0</td><td>3</td></tr> <tr><td>yellow shale</td><td>3</td><td>10</td></tr> <tr><td>blue shale</td><td>10</td><td>18</td></tr> <tr><td>white lime</td><td>18</td><td>21</td></tr> <tr><td>white sand water 24</td><td>21</td><td>26</td></tr> <tr><td>white lime</td><td>26</td><td>46</td></tr> <tr><td>white sand & blue shale</td><td>46</td><td>55</td></tr> <tr><td>white sand</td><td>55</td><td>105</td></tr> <tr><td>blue shale</td><td>105</td><td>125</td></tr> <tr><td colspan="3" style="text-align:center;">(use a second sheet if needed)</td></tr> </tbody> </table>				2 Type and color of material	From	To	black dirt	0	3	yellow shale	3	10	blue shale	10	18	white lime	18	21	white sand water 24	21	26	white lime	26	46	white sand & blue shale	46	55	white sand	55	105	blue shale	105	125	(use a second sheet if needed)			5 <input checked="" type="checkbox"/> Cable tool <input type="checkbox"/> Rotary <input type="checkbox"/> Driven <input type="checkbox"/> Dug <input type="checkbox"/> Hollow rod <input type="checkbox"/> Jetted <input type="checkbox"/> Bored <input type="checkbox"/> Reverse rotary	
				2 Type and color of material	From	To																																
				black dirt	0	3																																
				yellow shale	3	10																																
				blue shale	10	18																																
				white lime	18	21																																
				white sand water 24	21	26																																
				white lime	26	46																																
				white sand & blue shale	46	55																																
				white sand	55	105																																
blue shale	105	125																																				
(use a second sheet if needed)																																						
6 Use: <input type="checkbox"/> Domestic <input type="checkbox"/> Public supply <input type="checkbox"/> Industry <input checked="" type="checkbox"/> Irrigation <input type="checkbox"/> Air conditioning <input type="checkbox"/> Commercial <input type="checkbox"/> Test well <input type="checkbox"/>																																						
7 Casing: Material Plas Height: above/below Threaded <input type="checkbox"/> Welded <input checked="" type="checkbox"/> Surface 2.5 in. Diam. Weight 2.5 lbs./ft. ___ in. to ___ ft. depth! Drive shoe? <input type="checkbox"/> Yes <input checked="" type="checkbox"/> No ___ in. to ___ ft. depth!																																						
8 Screen: Manufacturer H. P. Type ___ Dia. ___ Slot/gauze ___ Length ___ Set between ___ ft. and ___ ft. ___ Fittings: Gravel pack <input checked="" type="checkbox"/> Yes <input type="checkbox"/> No Size range of material ___																																						
9 Static water level: 35 ft. below land surface Date 4-1-76																																						
10 Pumping level below land surfaces: ___ ft. after ___ hrs. pumping ___ g.p.m. ___ ft. after ___ hrs. pumping ___ g.p.m. Estimated maximum yield Two g.p.m.																																						
11 Water sample submitted: <input type="checkbox"/> Yes <input checked="" type="checkbox"/> No Date ___																																						
12 Well head completion: <input type="checkbox"/> Pitless adapter <input type="checkbox"/> 12 inches above grade																																						
13 Well grouted? <input checked="" type="checkbox"/> Yes <input type="checkbox"/> No <input checked="" type="checkbox"/> Neat cement <input type="checkbox"/> Bentonite <input type="checkbox"/> Depth: From 0 ft. to 15 ft.																																						
14 Nearest source of possible contamination: None ft. ___ Direction ___ Type ___ Well disinfected upon completion? <input type="checkbox"/> Yes <input type="checkbox"/> No																																						
15 Pump: <input type="checkbox"/> Not installed Manufacturer's name ___ Model number ___ HP ___ Volts ___ Length of drop pipe ___ ft. capacity ___ g.m.p. Type: Owner installed himself <input type="checkbox"/> Submersible <input type="checkbox"/> Turbine <input type="checkbox"/> Jet <input type="checkbox"/> Reciprocating <input type="checkbox"/> Centrifugal <input type="checkbox"/> Other																																						
16 Remarks: elevation Topography: <input type="checkbox"/> Hill <input type="checkbox"/> Slope <input checked="" type="checkbox"/> Upland <input type="checkbox"/> Valley				17 Water well contractor's certification: This well was drilled under my jurisdiction and this report is true to the best of my knowledge and belief. H.P.W.W.D. CO. 275 Business name License No. Address Box 47, Earlton, KS 66731 Signed Herbert C. Wolfe Date 4-7-76 Authorized representative																																		

27 18E 30 NE SW