


1 LOCATION OF WATER WELL: County: Neosho Fraction: W2 1/4 NE 1/4 NE 1/4 Section Number: 32 Township Number: T 27 S Range Number: R 18 E

Distance and direction from nearest town or city street address of well if located within city? 3/4 mile South 1/4 West Chanute, Ks

2 WATER WELL OWNER: KDHE RR#, St. Address, Box #: WP 1 City, State, ZIP Code: Board of Agriculture, Division of Water Resources Application Number:

3 LOCATE WELL'S LOCATION WITH AN "X" IN SECTION BOX:

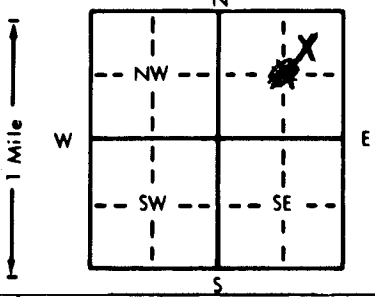

4 DEPTH OF COMPLETED WELL: 25.4 ft. ELEVATION: 934.25 GEL

Depth(s) Groundwater Encountered 1. 12 ft. 2. ft. 3. ft.  
WELL'S STATIC WATER LEVEL 6.13 ft. below land surface measured on mo/day/yr 09/26/86

Pump test data: Well water was ft. after hours pumping gpm  
Est. Yield gpm: Well water was ft. after hours pumping gpm

Bore Hole Diameter: 25.4 in. to ft., and in. to ft.  
WELL WATER TO BE USED AS: 5 Public water supply 8 Air conditioning 11 Injection well  
1 Domestic 3 Feedlot 6 Oil field water supply 9 Dewatering 12 Other (Specify below)  
2 Irrigation 4 Industrial 7 Lawn and garden only 10 Observation well

Was a chemical/bacteriological sample submitted to Department? Yes X No; If yes, mo/day/yr sample was submitted 10/86 Water Well Disinfected? Yes No

5 TYPE OF BLANK CASING USED: 1 Steel 3 RMP (SR) 5 Wrought iron 8 Concrete tile CASING JOINTS: Glued Clamped  
2 PVC 4 ABS 6 Asbestos-Cement 9 Other (specify below) Welded  
7 Fiberglass Threaded

Blank casing diameter 2 in. to 14.4 ft., Dia. in. to ft., Dia. in. to ft.  
Casing height above land surface 24.12 in., weight lbs./ft. Wall thickness or gauge No.

TYPE OF SCREEN OR PERFORATION MATERIAL: 1 Steel 3 Stainless steel 5 Fiberglass 7 PVC 10 Asbestos-cement  
2 Brass 4 Galvanized steel 6 Concrete tile 8 RMP (SR) 11 Other (specify)

SCREEN OR PERFORATION OPENINGS ARE: 1 Continuous slot 3 Mill slot 5 Gauzed wrapped 8 Saw cut 11 None (open hole)  
2 Louvered shutter 4 Key punched 6 Wire wrapped 9 Drilled holes  
7 Torch cut 10 Other (specify)

SCREEN-PERFORATED INTERVALS: From 14.4 ft. to 25.4 ft., From ft. to ft.  
From ft. to ft., From ft. to ft.

GRAVEL PACK INTERVALS: From 14.4 ft. to 25.4 ft., From ft. to ft.  
From ft. to ft., From ft. to ft.

6 GROUT MATERIAL: 1 Neat cement 2 Cement grout 3 Bentonite 10 Other  
Grout Intervals: From 0 ft. to 10 ft., From 10 ft. to 10 ft., From ft. to ft.

What is the nearest source of possible contamination: 1 Septic tank 4 Lateral lines 7 Pit privy 10 Livestock pens 14 Abandoned water well  
2 Sewer lines 5 Cess pool 8 Sewage lagoon 11 Fuel storage 15 Oil well/Gas well  
3 Watertight sewer lines 6 Seepage pit 9 Feedyard 12 Fertilizer storage 16 Other (specify below)  
13 Insecticide storage TANK BOTTOMS

Direction from well? East How many feet? 100'

FROM	TO	LITHOLOGIC LOG	FROM	TO	LITHOLOGIC LOG
0	1	Fill, WAXY BLACK MATERIAL			
1	5.0	Sandy Clay - Green			
5.0	11	brownish tan sand			
11	15	white dense sandstone			
15	20	brown sand some clay			
20	25.4	grey-blue shale			

7 CONTRACTOR'S OR LANDOWNER'S CERTIFICATION: This water well was (1) constructed, (2) reconstructed, or (3) plugged under my jurisdiction and was completed on (mo/day/year) 9/22/86 and this record is true to the best of my knowledge and belief. Kansas Water Well Contractor's License No. This Water Well Record was completed on (mo/day/yr) 1/37/87 under the business name of KDHE by (signature) [Signature]

INSTRUCTIONS: Use typewriter or ball point pen. PLEASE PRESS FIRMLY and PRINT clearly. Please fill in blanks, underline or circle the correct answers. Send top three copies to Kansas Department of Health and Environment, Office of Oil Field and Environmental Geology, Regulation and Permitting Section, Topeka, Kansas 66620-7500, Telephone: 913-862-9360. Send one to WATER WELL OWNER and retain one for your records.