


1 LOCATION OF WATER WELL: County: Neosho Fraction: NE 1/4 NE 1/4 SE 1/4 Section Number: 28 Township Number: T 27 S Range Number: R 18 E/W

Distance and direction from nearest town or city street address of well if located within city?

2110 S. Santa Fe, Chanute

2 WATER WELL OWNER: No Mug LLC RR#, St. Address, Box #: 2110 S. Santa Fe City, State, ZIP Code: Chanute, KS 66720 Board of Agriculture, Division of Water Resources Application Number:

3 LOCATE WELL'S LOCATION WITH AN "X" IN SECTION BOX:

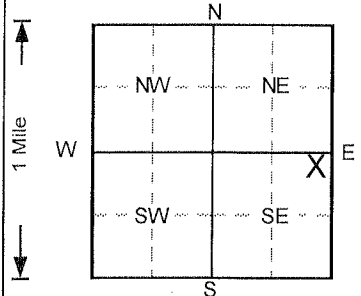

4 DEPTH OF COMPLETED WELL: 15 ft. ELEVATION: 959.87 ft. WELL'S STATIC WATER LEVEL: ... ft. below land surface measured on mo/day/yr ... Pump test data: Well water was NA ft. after ... hours pumping ... gpm Est. Yield: NA gpm ... Bore Hole Diameter: 8 in. to 15 ft. ... WELL WATER TO BE USED AS: 10 Monitoring well ... Was a chemical/bacteriological sample submitted? Yes No [checked] ... Water Well Disinfected? Yes No [checked]

5 TYPE OF BLANK CASING USED: 2 PVC 5 Wrought iron 8 Concrete tile CASING JOINTS: Threaded [checked] 7 PVC 10 Asbestos-cement TYPE OF SCREEN OR PERFORATION MATERIAL: 7 PVC 10 Asbestos-cement SCREEN OR PERFORATION OPENINGS ARE: 3 Mill slot 5 Gauzed wrapped 8 Saw cut 11 None (open hole) SCREEN-PERFORATED INTERVALS: From 5 ft to 15 ft. GRAVEL PACK INTERVALS: From 4 ft to 15 ft.

6 GROUT MATERIAL: 4 Other Concrete Grout Intervals: From 0 ft to 1 ft, From 1 ft to 4 ft, From ... ft to ... ft What is the nearest source of possible contamination: 10 Livestock pens 14 Abandoned water well 11 Fuel storage 15 Oil well/Gas well 12 Fertilizer storage 16 Other (specify below) 13 Insecticide storage

Table with columns: FROM, TO, LITHOLOGIC LOG, FROM, TO, PLUGGING INTERVALS. Rows include Asphalt Parking Lot, Concrete Parking Lot, Sandstone (Orange/Gray/Green), and Sandstone (Tan). MW14, Flushmount

7 CONTRACTOR'S OR LANDOWNER'S CERTIFICATION: This water well was (1) constructed, (2) reconstructed, or (3) plugged under my jurisdiction and was completed on (mo/day/year) 6/20/2011 and this record is true to the best of my knowledge and belief. Kansas Water Well Contractor's License No. 527 This Water Well Record was completed on (mo/day/yr) 7/19/2011 under the business name of GeoCore, Inc. by (signature) Dale Ball