

KDHE


MW-48

WATER WELL PLUGGING RECORD Form WWC-5P KSA 82a-1212 ID NO.

1 LOCATION OF WATER WELL: County: Neosho Fraction 1/4 se 1/4 sw 1/4 ne 1/4 Section Number 28 Township Number T 27 S Range Number 18 [X] E [] W

Street/Rural Address of Well Location; if unknown, distance & direction from nearest town or intersection: If at owner's address, check here [X] Former Kansas Cooperative Refinery 980 East 14th Street, Chanute, KS 66720 Global Positioning Systems (GPS) information: Latitude: 37.66989 Longitude: -95.43956 Elevation: 924 Horizontal Datum: [X] WGS84, [] NAD83, [] NAD27 Collection Method:

2 WATER WELL OWNER: RR#, St. Address, Box #: City, State ZIP Code: GPS unit (Make/Model: [] Digital Map/Photo, [] Topographic Map, [] Land Survey Est. Accuracy: [X] < 3 m, [] 3-5 m, [] 5-15 m, [] > 15 m

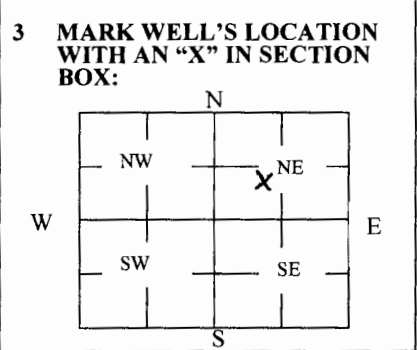

4 DEPTH OF WELL 27.91 ft. WELL'S STATIC WATER LEVEL 20.19 ft. WELL WAS USED AS: [] Domestic [] Irrigation [] Feedlot [] Industrial [] Public Water Supply [] Oil Field Water Supply [] Domestic (Lawn & Garden) [] Air Conditioning [] Dewatering [X] Monitoring [] Injection Well [] Other Was a chemical/bacteriological sample submitted to Department? Yes [] No [X]

5 TYPE OF BLANK CASING USED: [X] Steel PVC [] RMP (SR) ABS [] Wrought Asbestos-Cement [] Fiberglass Concrete Tile [] Other (Specify below) Blank casing diameter 2 in. Was casing pulled? Yes [] No [X] If yes, how much Casing height above or below land surface 36 in.

6 GROUT PLUG MATERIAL: [] Neat cement [] Cement grout [X] Bentonite [] Other Grout Plug Intervals: From 3 ft. to 27.91 ft., From ft. to ft., From ft. to ft. What is the nearest source of possible contamination: [X] Sewer lines [] Septic tank [] Watertight sewer lines [] Lateral lines [] Cess pool [] Seepage pit [] Pit privy [] Sewage lagoon [] Feedyard [] Livestock pens [] Fuel storage [] Fertilizer storage [] Insecticide storage [] Abandoned water well [] Oil well/Gas well [] Other (specify below) Direction from well? East How many feet? 500

Table with 6 columns: FROM, TO, PLUGGING MATERIALS, FROM, TO, PLUGGING MATERIALS. Row 1: 0, 3, native clay. Row 2: 3, 27.91, Bentonite.

7 CONTRACTOR'S OR LANDOWNER'S CERTIFICATION: This water well was plugged under my jurisdiction and was completed on (mo/day/year) 2/22/16 and this record is true to the best of my knowledge and belief. Kansas Water Well Contractor's License No. 851. This Water Well Record was completed on (mo/day/year) under the business name of GHD by (signature)

Send one white copy to Kansas Department of Health & Environment, Geology Section, 1000 SW Jackson Street, Ste. 420, Topeka, KS 66612-1367. Send one copy to WATER WELL OWNER and retain one for your records. Visit us at http://www.kdheks.gov/waterwell/index.html Telephone 785-296-5524.