

SWP-6A

Blank box for ID number


WATER WELL PLUGGING RECORD Form WWC-5P KSA 82a-1212 ID NO.

1 LOCATION OF WATER WELL: Fraction NE 1/4 SE 1/4 NE 1/4 SE 1/4 Section Number 17 Township Number T 27 S Range Number 18 [X] E [ ] W

Street/Rural Address of Well Location; if unknown, distance & direction from nearest town or intersection: If at owner's address, check here [ ] Corner of W. Hickory St. and N. Santa Fe Ave. Chanute KS

Global Positioning Systems (GPS) information: Latitude: 37.69439 (in decimal degrees) Longitude: -95.45294 (in decimal degrees) Elevation: Horizontal Datum: [X] WGS84, [ ] NAD83, [ ] NAD27 Collection Method: [X] GPS unit (Make/Model: Garmin eTrex) [ ] Digital Map/Photo, [ ] Topographic Map, [ ] Land Survey Est. Accuracy: [ ] < 3 m, [X] 3-5 m, [ ] 5-15 m, [ ] > 15 m

2 WATER WELL OWNER: MFA Oil Co. RR#, St. Address, Box #: PO Box 519 City, State ZIP Code: Columbia MO 65205

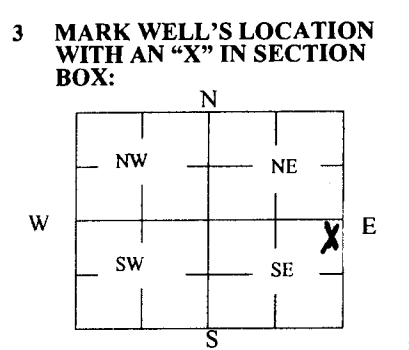

3 MARK WELL'S LOCATION WITH AN "X" IN SECTION BOX: 4 DEPTH OF WELL 22 ft. WELL'S STATIC WATER LEVEL \_\_\_\_\_ ft. WELL WAS USED AS: [ ] Domestic [ ] Irrigation [ ] Feedlot [ ] Industrial [ ] Public Water Supply [ ] Oil Field Water Supply [ ] Domestic (Lawn & Garden) [ ] Air Conditioning [X] Dewatering [X] Monitoring [ ] Injection Well [ ] Other \_\_\_\_\_ Was a chemical/bacteriological sample submitted to Department? Yes [ ] No [X]

5 TYPE OF BLANK CASING USED: [X] Steel [ ] RMP (SR) [ ] Wrought [ ] Fiberglass [ ] Other (Specify below) [X] PVC [ ] ABS [ ] Asbestos-Cement [ ] Concrete Tile Blank casing diameter 0.5 in. Was casing pulled? Yes [X] No [ ] If yes, how much all Casing height above or below land surface -6 in.

6 GROUT PLUG MATERIAL: [ ] Neat cement [ ] Cement grout [X] Bentonite [ ] Other \_\_\_\_\_ Grout Plug Intervals: From 3 ft. to 22 ft., From - ft. to - ft., From - ft. to - ft.

What is the nearest source of possible contamination: [ ] Septic tank [ ] Sewer lines [ ] Watertight sewer lines [ ] Lateral lines [ ] Cess pool [ ] Seepage pit [ ] Pit privy [ ] Sewage lagoon [ ] Feedyard [ ] Livestock pens [ ] Fuel storage [ ] Fertilizer storage [ ] Insecticide storage [ ] Abandoned water well [ ] Oil well/Gas well [X] Other (specify below) former fuel storage Direction from well? SW How many feet? 150

Table with columns: FROM, TO, PLUGGING MATERIALS. Row 1: 0, 3, Top Soil. Row 2: 3, 22, Bentonite.

7 CONTRACTOR'S OR LANDOWNER'S CERTIFICATION: This water well was plugged under my jurisdiction and was completed on (mo/day/year) 5-3-16 and this record is true to the best of my knowledge and belief. Kansas Water Well Contractor's License No. 710. This Water Well Record was completed on (mo/day/year) 5/6/16 under the business name of Below Ground Surface, Inc. by (signature) [Signature]

Send one white copy to Kansas Department of Health & Environment, Geology Section, 1000 SW Jackson Street, Ste. 420, Topeka, KS 66612-1367. Send one copy to WATER WELL OWNER and retain one for your records. Visit us at http://www.kdheks.gov/waterwell/index.html Telephone 785-296-5524.