

WATER WELL RECORD Form WWC-5


Original Record Correction Change in Well Use

Division of Water Resources App. No.

Well ID

1 LOCATION OF WATER WELL: County: Neosho Fraction 1/4 SE 1/4 SW 1/4 NE 1/4 Section Number 28 Township Number T 27 S Range Number R 18 E

2 WELL OWNER: Last Name: Phillips 66 Business: Phillips 66 Address: 1708-02 Phillips Building City: Bartlesville State: OK ZIP: 74004 Street or Rural Address where well is located: Former Cooperative Refinery 980 E 14th St, Chanute, KS

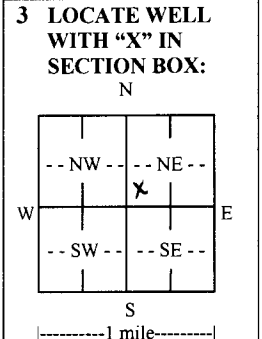

3 LOCATE WELL WITH 'X' IN SECTION BOX: 4 DEPTH OF COMPLETED WELL: 28 ft. Depth(s) Groundwater Encountered: 1) NA ft. 2) NA ft. 3) NA ft. or 4) Dry Well

5 Latitude: 37.668908 Longitude: -95.438217 Horizontal Datum: WGS 84 NAD 83 NAD 27 Source for Latitude/Longitude: GPS (unit make/model): Google Earth

6 Elevation: 924 ft. Source: Land Survey GPS Topographic Map Other

7 WELL WATER TO BE USED AS: 1. Domestic 2. Irrigation 3. Feedlot 4. Industrial 5. Public Water Supply: well ID 6. Dewatering: how many wells? 7. Aquifer Recharge: well ID 8. Monitoring: well ID 9. Environmental Remediation: well ID AS-21 10. Oil Field Water Supply: lease 11. Test Hole: well ID 12. Geothermal: how many bores? 13. Other (specify):

Was a chemical/bacteriological sample submitted to KDHE? Yes No If yes, date sample was submitted: NA

8 TYPE OF CASING USED: Steel PVC Other CASING JOINTS: Glued Clamped Welded Threaded Casing diameter 2 in. to 26 ft. Diameter NA in. to NA ft. Casing height above land surface 12 in. Weight NA lbs./ft. Wall thickness or gauge No. SCH 40

9 GROUT MATERIAL: Neat cement Cement grout Bentonite Other Granular bent: 24.5-25.0 Grout Intervals: From 0 ft. to 24.5 ft. From NA ft. to NA ft.

Nearest source of possible contamination: Septic Tank Lateral Lines Pit Privy Livestock Pens Insecticide Storage Sewer Lines Cess Pool Sewage Lagoon Fuel Storage Abandoned Water Well Watertight Sewer Lines Seepage Pit Feedyard Fertilizer Storage Oil Well/Gas Well

Table with columns: FROM, TO, LITHOLOGIC LOG, FROM, TO, LITHO. LOG (cont.) or PLUGGING INTERVALS. Includes a Notes section: Direct Push- no sampling conducted

11 CONTRACTOR'S OR LANDOWNER'S CERTIFICATION: This water well was constructed reconstructed, or plugged under my jurisdiction and was completed on (mo-day-year) 10/28/16 and this record is true to the best of my knowledge and belief.