

Corrected

## WATER WELL PLUGGING RECORD Form WWC-5P

KSA 82a-1212 ID NO.

MAEST 13-2

1 LOCATION OF WATER WELL: County: Neosho	Fraction NW ¼ SE ¼ SW ¼ SW ¼	Section Number 18	Township Number 27 T S	Range Number 18 E W
---	---------------------------------	----------------------	---------------------------	------------------------

Street/Rural Address of Well Location; if unknown, distance & direction from nearest town or intersection: If at owner's address, check here ☒ 1801 N Santa Fe  
Chanute, Kansas 66720

## Global Positioning Systems (GPS) information:

Latitude: 37.69037 (in decimal degrees)

Longitude: 95.48666 (in decimal degrees)

Elevation: 936


Datum: ☐ WGS84, ☒ NAD83, ☐ NAD27

## Collection Method:

☒ GPS unit (Make/Model: Garmin Etrex 20)☐ Digital Map/Photo, ☐ Topographic Map, ☐ Land SurveyEst. Accuracy: ☐ < 3 m, ☐ 3-5 m, ☒ 5-15 m, ☐ > 15 m

2 WATER WELL OWNER: Ash Grove Cement  
RR#, St. Address, Box #: 1801 N Santa Fe  
City, State ZIP Code: Chanute Kansas 66720

## 3 MARK WELL'S LOCATION WITH AN "X" IN SECTION BOX:

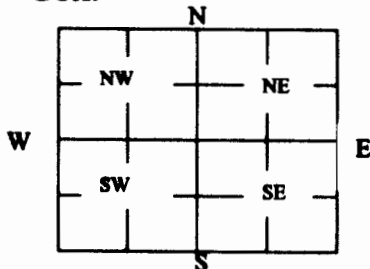

## 4 DEPTH OF WELL 8 ft.

WELL'S STATIC WATER LEVEL 5 ft

## WELL WAS USED AS:

☐ Domestic  
☐ Irrigation  
☐ Feedlot  
☐ Industrial

☐ Public Water Supply  
☐ Oil Field Water Supply  
☐ Domestic (Lawn & Garden)  
☐ Air Conditioning

☐ Dewatering  
☒ Monitoring  
☐ Injection Well  
☐ Other
Was a chemical/bacteriological sample submitted to Department? Yes ☐ No ☒

## 5 TYPE OF BLANK CASING USED:

☐ Steel  
☒ PVC☐ RMP (SR)  
☐ ABS☐ Wrought  
☐ Asbestos-Cement☐ Fiberglass  
☐ Concrete Tile☐ Other (Specify below)

Blank casing diameter 2 in. Was casing pulled? Yes ☒ No ☐ If yes, how much 5  
Casing height above or below land surface 30 in.

6 GROUT PLUG MATERIAL: ☐ Neat cement ☐ Cement grout ☒ Bentonite ☐ Other

Grout Plug Intervals: From 8 ft. to 3 ft., From 3 ft. to 0 ft., From ft. to ft.

## What is the nearest source of possible contamination:

☐ Septic tank  
☐ Sewer lines  
☐ Watertight sewer lines  
☐ Lateral lines  
☐ Cess pool

☐ Seepage pit  
☐ Pit privy  
☐ Sewage lagoon  
☐ Feedyard  
☐ Livestock pens

☐ Fuel storage  
☐ Fertilizer storage  
☐ Insecticide storage  
☐ Abandoned water well  
☐ Oil well/Gas well
☒ Other (specify below)  
Ash Groves Landfill

Direction from well? n  
How many feet? 100

FROM	TO	PLUGGING MATERIALS	FROM	TO	PLUGGING MATERIALS

7 CONTRACTOR'S OR LANDOWNER'S CERTIFICATION: This water well was plugged under my jurisdiction and was completed on (mo/day/year) 06/11/2018 and this record is true to the best of my knowledge and belief. Kansas Water Well Contractor's License No. 529. This Water Well Record was completed on (mo/day/year) 06/13/2018 under the business name of Geotechnology by (signature)

Send one white copy to Kansas Department of Health & Environment, Geology Section, 1000 SW Jackson Street, Ste. 420, Topeka, KS 66612-1367. Send one copy to WATER WELL OWNER and retain one for your records.  
Visit us at <http://www.kdheks.gov/waterwell/index.html> Telephone 785-296-5524.