

WATER WELL PLUGGING RECORD Form WWC-5P

KSA 82a-1212 ID NO.

443573 (MW 25)


1 LOCATION OF WATER WELL: County: NEOSHO	Fraction NW ¼ SE ¼ NE ¼ ¼	Section Number 28	Township Number T 27 S	Range Number 18 <input checked="" type="checkbox"/> E <input type="checkbox"/> W
---	-------------------------------------	-----------------------------	----------------------------------	--

Street/Rural Address of Well Location; if unknown, distance & direction from nearest town or intersection: If at owner's address, check here **980 E 14TH ST, CHANUTE**
1218 PHILLIPS BLDG

Global Positioning Systems (GPS) information:
Latitude: **37.6709624** (in decimal degrees)
Longitude: **-95.438309** (in decimal degrees)
Elevation: _____
Horizontal Datum: WGS84, NAD83, NAD27
Collection Method: **8ft**

2 WATER WELL OWNER: PHILLIPS 66 COMPANY
RR#, St. Address, Box #: **411 S. Keeler Ave**
City, State ZIP Code: **Bartlesville, OK 74003**

GPS unit (Make/Model: **Trimble GeoXH**)
 Digital Map/Photo, Topographic Map, Land Survey
Est. Accuracy: < 3 m, 3-5 m, 5-15 m, > 15 m

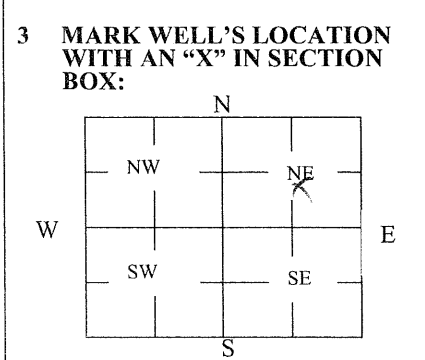

4 DEPTH OF WELL 21 ft.
WELL'S STATIC WATER LEVEL _____ ft.
WELL WAS USED AS:
 Domestic Public Water Supply Dewatering
 Irrigation Oil Field Water Supply Monitoring
 Feedlot Domestic (Lawn & Garden) Injection Well
 Industrial Air Conditioning Other _____
Was a chemical/bacteriological sample submitted to Department? Yes No

5 TYPE OF BLANK CASING USED:

Steel RMP (SR) Wrought Fiberglass Other (Specify below)
 PVC ABS Asbestos-Cement Concrete Tile

Blank casing diameter **2.0** in. Was casing pulled? Yes No If yes, how much **to 3 feet bgl**
Casing height above or below land surface **30** in.

6 GROUT PLUG MATERIAL: Neat cement Cement grout Bentonite Other **Topsoil**

Grout Plug Intervals: From **0** ft. to **3** ft., From **3** ft. to **21** ft., From _____ ft. to _____ ft.

What is the nearest source of possible contamination:
 Septic tank Seepage pit Fuel storage Other (specify below)
 Sewer lines Pit privy Fertilizer storage **Former Refinery**
 Watertight sewer lines Sewage lagoon Insecticide storage
 Lateral lines Feedyard Abandoned water well Direction from well? **West**
 Cess pool Livestock pens Oil well/Gas well How many feet? **100**

FROM	TO	PLUGGING MATERIALS	FROM	TO	PLUGGING MATERIALS
0	3'	Topsoil			
3	21'	Bentonite			

Cooperative Refinery – Chanute C306771686

7 CONTRACTOR'S OR LANDOWNER'S CERTIFICATION: This water well was plugged under my jurisdiction and was completed on (mo/day/year) **04/29/2024** and this record is true to the best of my knowledge and belief. Kansas Water Well Contractor's License No. **759**. This Water Well Record was completed on (mo/day/year) **05/30/2024** under the business name of **Razek Environmental, LLC** by (signature) _____

Send one white copy to Kansas Department of Health & Environment, Geology Section, 1000 SW Jackson Street, Ste. 420, Topeka, KS 66612-1367. Send one copy to WATER WELL OWNER and retain one for your records.
Visit us at <http://www.kdheks.gov/waterwell/index.html> Telephone 785-296-5524.