


498067 (SVE 1D)

WATER WELL PLUGGING RECORD Form WWC-5P KSA 82a-1212 ID NO.

1 LOCATION OF WATER WELL: County: NEOSHO Fraction SW 1/4 SE 1/4 NE 1/4 Section Number 28 Township Number T 27 S Range Number 18 [X] E [] W

Street/Rural Address of Well Location; if unknown, distance & direction from nearest town or intersection: If at owner's address, check here [] 980 E 14TH ST, CHANUTE 1218 PHILLIPS BLDG Global Positioning Systems (GPS) information: Latitude: 37.6701731 Longitude: -95.4377964 Elevation: 918 Horizontal Datum: [] WGS84, [] NAD83, [X] NAD27 Collection Method: 8A

2 WATER WELL OWNER: PHILLIPS 66 COMPANY RR#, St. Address, Box #: 411 S. Keeler Ave City, State ZIP Code: Bartlesville, OK 74003 [X] GPS unit (Make/Model: Trimble GeoXH [] Digital Map/Photo, [] Topographic Map, [] Land Survey Est. Accuracy: [X] < 3 m, [] 3-5 m, [] 5-15 m, [] > 15 m

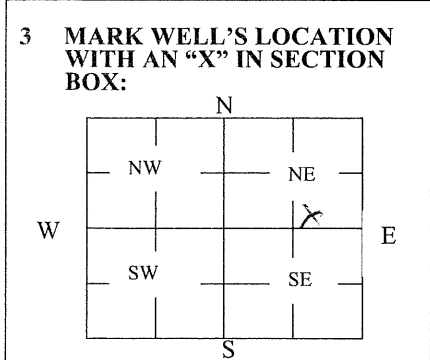

4 DEPTH OF WELL 10 ft. WELL'S STATIC WATER LEVEL _____ ft. WELL WAS USED AS: [] Domestic [] Irrigation [] Feedlot [] Industrial [] Public Water Supply [] Oil Field Water Supply [] Domestic (Lawn & Garden) [] Air Conditioning [] Dewatering [] Monitoring [] Injection Well [X] Other SVE Was a chemical/bacteriological sample submitted to Department? Yes [] No [X]

5 TYPE OF BLANK CASING USED: [] Steel [X] PVC [] RMP (SR) [] ABS [] Wrought Asbestos-Cement [] Fiberglass [] Concrete Tile [] Other (Specify below) Blank casing diameter 2.0 in. Was casing pulled? Yes [X] No [] If yes, how much to 3 feet bgl Casing height above or below land surface 30 in.

6 GROUT PLUG MATERIAL: [] Neat cement [] Cement grout [X] Bentonite [X] Other Topsoil Grout Plug Intervals: From 0 ft. to 3 ft., From 3 ft. to 10 ft., From _____ ft. to _____ ft. What is the nearest source of possible contamination: [] Septic tank [] Sewer lines [] Watertight sewer lines [] Lateral lines [] Cess pool [] Seepage pit [] Pit privy [] Sewage lagoon [] Feedyard [] Livestock pens [] Fuel storage [] Fertilizer storage [] Insecticide storage [] Abandoned water well [] Oil well/Gas well [X] Other (specify below) Former Refinery Site (Closed) Direction from well? _____ How many feet? _____

Table with columns: FROM, TO, PLUGGING MATERIALS. Row 1: 0, 3', Topsoil. Row 2: 3, 10', Bentonite. Note: Cooperative Refinery - Chanute C306771686

7 CONTRACTOR'S OR LANDOWNER'S CERTIFICATION: This water well was plugged under my jurisdiction and was completed on (mo/day/year) 04/29/2024 and this record is true to the best of my knowledge and belief. Kansas Water Well Contractor's License No. 759. This Water Well Record was completed on (mo/day/year) 05/30/2024 under the business name of Razek Environmental, LLC by (signature)

Send one white copy to Kansas Department of Health & Environment, Geology Section, 1000 SW Jackson Street, Ste. 420, Topeka, KS 66612-1367. Send one copy to WATER WELL OWNER and retain one for your records. Visit us at http://www.kdheks.gov/waterwell/index.html Telephone 785-296-5524.