


02958005

DMW-2

1 LOCATION OF WATER WELL: Fraction SE 1/4 SE 1/4 SW 1/4 Section Number 27 Township Number T 27 S Range Number R 18 EW
 County: NEOSHO

Distance and direction from nearest town or city street address of well if located within city?
1.5 MILES S.E. OF DOWNTOWN CHANUTE, KS

2 WATER WELL OWNER: CITY OF CHANUTE
 RR#, St. Address, Box #: MEMORIAL BLDG Board of Agriculture, Division of Water Resources
 City, State, ZIP Code: 101 S. LINCOLN CHANUTE, KS 66270 Application Number: _____

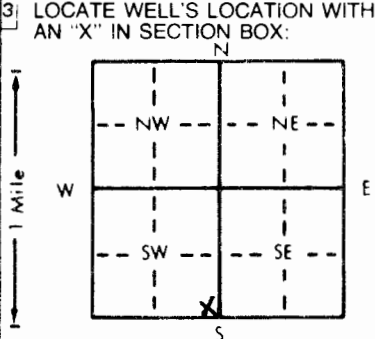

4 DEPTH OF COMPLETED WELL: 24.0 ft. ELEVATION: _____
 Depth(s) Groundwater Encountered 1. 18.5 ft. 2. _____ ft. 3. _____ ft.
 WELL'S STATIC WATER LEVEL 20.22 ft. below land surface measured on mo/day/yr 4/7/95
 Pump test data: Well water was _____ ft. after _____ hours pumping _____ gpm
 Est. Yield _____ gpm: Well water was _____ ft. after _____ hours pumping _____ gpm
 Bore Hole Diameter: 8.25 in. to 24.4 in. and _____ in. to _____ in.
 WELL WATER TO BE USED AS:
 5 Public water supply 8 Air conditioning 11 Injection well
 1 Domestic 3 Feedlot 6 Oil field water supply 9 Dewatering 12 Other (Specify below)
 2 Irrigation 4 Industrial 7 Lawn and garden only 10 Monitoring well
 Was a chemical/bacteriological sample submitted to Department? Yes _____ No ✓; If yes, mo/day/yr sample was submitted _____
 Water Well Disinfected? Yes _____ No ✓

5 TYPE OF BLANK CASING USED:
 1 Steel 3 RMP (SR) 5 Wrought iron 8 Concrete tile CASING JOINTS: Glued _____ Clamped _____
2 PVC 4 ABS 6 Asbestos-Cement 9 Other (specify below) Welded _____
 7 Fiberglass Threaded ✓
 Blank casing diameter 2 in. to 14.0 ft. Dia _____ in. to _____ ft. Dia _____ in. to _____ ft.
 Casing height above land surface: 30 in., weight _____ lbs./ft. Wall thickness or gauge No. SCHEDULE 40
 TYPE OF SCREEN OR PERFORATION MATERIAL: 7 PVC 10 Asbestos-cement
 1 Steel 3 Stainless steel 5 Fiberglass 8 RMP (SR) 11 Other (specify) _____
 2 Brass 4 Galvanized steel 6 Concrete tile 9 ABS 12 None used (open hole)
 SCREEN OR PERFORATION OPENINGS ARE:
 1 Continuous slot 3 Mill slot 0.010" 5 Gauzed wrapped 8 Saw cut 11 None (open hole)
 2 Louvered shutter 4 Key punched 6 Wire wrapped 9 Drilled holes
 7 Torch cut 10 Other (specify) _____
 SCREEN-PERFORATED INTERVALS: From 14.0 ft. to 24.0 ft. From _____ ft. to _____ ft.
 From _____ ft. to _____ ft. From _____ ft. to _____ ft.
 GRAVEL PACK INTERVALS: From 12.0 ft. to 24.0 ft. From _____ ft. to _____ ft.
 From _____ ft. to _____ ft. From _____ ft. to _____ ft.

6 GROUT MATERIAL: 1 Neat cement 2 Cement grout 3 Bentonite 4 Other
 Grout Intervals: From 0.0 ft. to 11.8 ft. From 11.8 ft. to 12.0 ft. From _____ ft. to _____ ft.
 What is the nearest source of possible contamination:
 1 Septic tank 4 Lateral lines 7 Pit privy 10 Livestock pens 14 Abandoned water well
 2 Sewer lines 5 Cess pool 8 Sewage lagoon 11 Fuel storage 15 Oil well/Gas well
 3 Watertight sewer lines 6 Seepage pit 9 Feedyard 12 Fertilizer storage 16 Other (specify below) LANDFILL
 13 Insecticide storage
 Direction from well? _____ How many feet? 900

FROM	TO	LITHOLOGIC LOG	FROM	TO	PLUGGING INTERVALS
0.0	1.0	TOPSOIL			
1.0	14.0	GRAY BRN CLAY			
14.0	18.5	RED BRN SANDY CLAY			
18.5	22.5	LT BRN FINE TO MED SAND			
22.5	24.4	GRAY SHALE			

7 CONTRACTOR'S OR LANDOWNER'S CERTIFICATION: This water well was 1 constructed, (2) reconstructed, or (3) plugged under my jurisdiction and was completed on (mo/day/year) 4/07/95 and this record is true to the best of my knowledge and belief. Kansas Water Well Contractor's License No. 416 This Water Well Record was completed on (mo/day/yr) 5/10/95 under the business name of TERRACON CONSULTANTS INC by (signature) [Signature]

OFFICE USE ONLY T R EW SEC. 1/4 1/4 1/4