


02958005

DMW-4

1 LOCATION OF WATER WELL: Fraction **NE 1/4 SW 1/4 SW 1/4** Section Number **27** Township Number **T 27 S** Range Number **R 18 E**
 County: **NEOSHO**

Distance and direction from nearest town or city street address of well if located within city?
1.5 MILES S.E. OF DOWNTOWN CHANUTE, KS

2 WATER WELL OWNER: **CITY OF CHANUTE**
 RR#, St. Address, Box #: **MEMORIAL BLDG.**
 City, State, ZIP Code: **101 S. LINCOLN, CHANUTE, KS 66270**
 Board of Agriculture, Division of Water Resources Application Number:

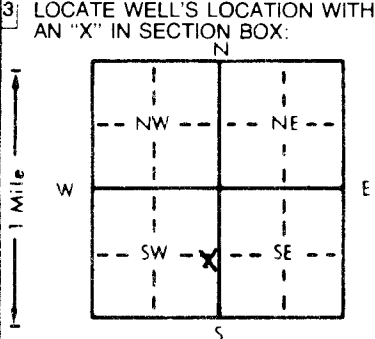

4 DEPTH OF COMPLETED WELL: **27.0** ft. ELEVATION:
 Depth(s) Groundwater Encountered 1. **18.8** ft. 2. ft. 3. ft.
 WELL'S STATIC WATER LEVEL **21.06** ft. below land surface measured on **mo/day/yr 4/7/95**
 Pump test data: Well water was ft. after hours pumping gpm
 Est. Yield gpm: Well water was ft. after hours pumping gpm
 Bore Hole Diameter: **8.25** in. to **27.0** ft., and in. to ft.
 WELL WATER TO BE USED AS:
 1 Domestic 2 Irrigation 3 Feedlot 4 Industrial 5 Public water supply 6 Oil field water supply 7 Lawn and garden only 8 Air conditioning 9 Dewatering 10 Monitoring well 11 Injection well 12 Other (Specify below)
 Was a chemical/bacteriological sample submitted to Department? Yes No If yes, mo/day/yr sample was submitted
 Water Well Disinfected? Yes No

5 TYPE OF BLANK CASING USED:
 1 Steel 2 PVC 3 RMP (SR) 4 ABS 5 Wrought iron 6 Asbestos-Cement 7 Fiberglass 8 Concrete tile 9 Other (specify below) 10 Asbestos-cement 11 Injection well 12 Other (Specify below)
 Blank casing diameter: **2** in. to **17.0** ft. Dia. in. to in. Dia. in. to in. Dia. in. to in. ft.
 Casing height above land surface: **30** in. weight lbs./ft. Wall thickness or gauge No. **SCHEDULE 40**

TYPE OF SCREEN OR PERFORATION MATERIAL:
 1 Steel 2 Brass 3 Stainless steel 4 Galvanized steel 5 Fiberglass 6 Concrete tile 7 PVC 8 RMP (SR) 9 ABS 10 Asbestos-cement 11 Other (specify) 12 None used (open hole)
 SCREEN OR PERFORATION OPENINGS ARE:
 1 Continuous slot 2 Louvered shutter 3 Mill slot **0.010"** 4 Key punched 5 Gauzed wrapped 6 Wire wrapped 7 Torch cut 8 Saw cut 9 Drilled holes 10 Other (specify) 11 None (open hole)
 SCREEN-PERFORATED INTERVALS: From **17.0** ft. to **27.0** ft. From ft. to ft. From ft. to ft. From ft. to ft.
 GRAVEL PACK INTERVALS: From **15.0** ft. to **27.0** ft. From ft. to ft. From ft. to ft. From ft. to ft.

6 GROUT MATERIAL:
 1 Neat cement 2 Cement grout 3 Bentonite 4 Other
 Grout Intervals: From **0.0** ft. to **15** ft. From **14.0** ft. to **15.0** ft. From ft. to ft. From ft. to ft.
 What is the nearest source of possible contamination:
 1 Septic tank 2 Sewer lines 3 Watertight sewer lines 4 Lateral lines 5 Cess pool 6 Seepage pit 7 Pit privy 8 Sewage lagoon 9 Feedyard 10 Livestock pens 11 Fuel storage 12 Fertilizer storage 13 Insecticide storage 14 Abandoned water well 15 Oil well/Gas well 16 Other (specify below) **LANDFILL**
 Direction from well? **100**
 How many feet?

FROM	TO	LITHOLOGIC LOG	FROM	TO	PLUGGING INTERVALS
0.0	1.0	TOPSOIL			
1.0	13.5	GRAY BRN CLAY			
13.5	19.0	RED BRN CLAY			
19.0	23.0	LT BRN FINE TO MED. SAND			
23.0	27.0	GRAY SHALE			

7 CONTRACTOR'S OR LANDOWNER'S CERTIFICATION: This water well was constructed, reconstructed, or plugged under my jurisdiction and was completed on (mo/day/year) **4/7/95** and this record is true to the best of my knowledge and belief. Kansas Water Well Contractor's License No. **416** This Water Well Record was completed on (mo/day/yr) **5/16/95** under the business name of **TERRACON CONSULTANTS INC** by (signature) *[Signature]*

OFFICE USE ONLY
T
R
EM
SEC
1/4
1/4
1/4