

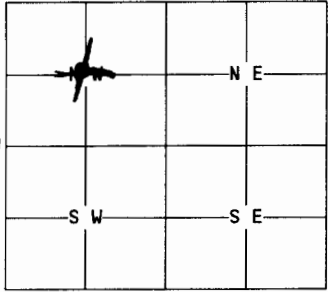
NW NE NE SE

1	LOCATION OF WATER WELL:	Fraction	Section Number	Township Number	Range Number
	County: <u>Sedgwick</u>	Near ^{1/4} <u>Center</u> ^{1/4} <u>NW</u>	<u>2A 8</u>	<u>27</u>	<u>2 EAST</u> <u>16W</u>

Distance and direction from nearest town or city street address of well if located within city?

In City Limits-1620 Laurel Court Cove

2	WATER WELL OWNER: <u>Dr. Duane Murphy</u>	Board of Agriculture, Division of Water Resources
	RR#, St. Address, Box #: <u>1620 Laurel Court</u>	Application Number:
	City, State, ZIP Code: <u>Wichita, KS 67201</u>	

3	MARK WELL'S LOCATION WITH AN "X" IN SECTION BOX: N	4	DEPTH OF WELL.... <u>150</u>ft.												
			WELL'S STATIC WATER LEVEL.....ft.												
			WELL WAS USED AS:												
			<table border="0"> <tr> <td>1 Domestic</td> <td>5 Public Water Supply</td> <td>9 Dewatering</td> </tr> <tr> <td>2 Irrigation</td> <td>6 Oil Field Water Supply</td> <td>10 Monitoring Well</td> </tr> <tr> <td>3 Feedlot</td> <td>7 Lawn and Garden Only</td> <td>11 Injection Well</td> </tr> <tr> <td>4 Industrial</td> <td>8 Air Conditioning</td> <td>12 Other <u>Heat Pump</u></td> </tr>
			Was a chemical/bacteriological sample submitted to Department? Yes....No <u>X</u> ..												
			If yes, mo/day/yr sample was submitted.....												
			Water Well Disinfected: Yes <u>X</u> ... No.....												

5	TYPE OF BLANK CASING USED:										
	<table border="0"> <tr> <td>1 Steel</td> <td>3 RMP (SR)</td> <td>5 Wrought</td> <td>7 Fiberglass</td> <td>9 Other (specify below)</td> </tr> <tr> <td>2 PVC</td> <td>4 ABS</td> <td>6 Asbestos-Cement</td> <td>8 Concrete Tile</td> <td><u>polythene</u></td> </tr> </table>	1 Steel	3 RMP (SR)	5 Wrought	7 Fiberglass	9 Other (specify below)	2 PVC	4 ABS	6 Asbestos-Cement	8 Concrete Tile	<u>polythene</u>
	Blank casing diameter.. <u>3/4</u> ...in. Was casing pulled? Yes..... No... <u>X</u> . If yes, how much.....										
	Casing height above or below land surface.....in.										

6	GROUT PLUG MATERIAL: 1 Neat cement 2 Cement grout <u>3 Bentonite</u> 4 Other.....																				
	Grout Plug Intervals: From.. <u>0</u> ...ft. to <u>150</u> ..ft., From.....ft. toft., From..... to.....ft.																				
	What is the nearest source of possible contamination:																				
	<table border="0"> <tr> <td>1 Septic tank</td> <td>6 Seepage pit</td> <td>11 Fuel storage</td> <td>16 Other (specify below)</td> </tr> <tr> <td>2 Sewer lines</td> <td>7 Pit privy</td> <td>12 Fertilizer storage</td> <td></td> </tr> <tr> <td>3 Watertight sewer lines</td> <td>8 Sewage lagoon</td> <td>13 Insecticide storage</td> <td></td> </tr> <tr> <td>4 Lateral lines</td> <td>9 Feedyard</td> <td>14 Abandoned water well</td> <td></td> </tr> <tr> <td>5 Cess Pool</td> <td>10 Livestock pens</td> <td>15 Oil well/Gas well</td> <td></td> </tr>
	Direction from well? <u>West</u> How many feet? <u>60</u> ..ft.....																				

FROM	TO	PLUGGING MATERIALS
0	1	<u>Top Soil</u>
1	11	<u>Tan Clay</u>
11	73	<u>Dark Gray Clay</u>
73	92	<u>Light Gray Clay</u>
92	95	<u>Limestone</u>
95	136	<u>Light Gray Clay</u>
136	150	<u>Limestone Layers w/Gray Shale</u>

7	CONTRACTOR'S OR LANDOWNER'S CERTIFICATION: This water well was plugged under my jurisdiction and was completed on (mo/day/year).... <u>9-20-95</u> and this record is true to the best of my knowledge and belief. Kansas Water Well Contractor's License No. <u>138</u> This Water Well Record was completed on (mo/day/year) <u>10-1-95</u> under the business name of <u>Peterson Irrigation, Inc.</u> by (signature) <u>Mike Peterson</u>
---	--

INSTRUCTIONS: Use typewriter or ball point pen. Please press firmly and print clearly. Please fill in blanks, underline or circle the correct answers. Send top three copies to Kansas Department of Health and Environment, Bureau of Water, Topeka, Kansas 66620-0001. Telephone: 913/296-3565. Send one to Water Well Owner and retain one for your records.