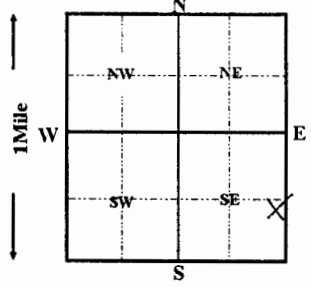


1 LOCATION OF WATER WELL: Sedgwick	FRACTION NE SW 1/4 SE 1/4 NE 1/4 SE 1/4	Section Number 15	Township Number T 27 S	Range Number R 2E EAV
--	---	-----------------------------	----------------------------------	---------------------------------

Distance and direction from nearest town or city street address of well if located within city?
747 N. 127th E. Wichita, Kansas

2 WATER WELL OWNER: EAST POINT CHURCH OF CHRIST	Board of Agriculture, Division of Water Resource
RR#, ST. ADDRESS, BOX #: 747 N. 127TH E.	Application Number:
CITY, STATE, ZIP CODE: Wichita, Kansas	

3 LOCATE WELL'S LOCATION WITH AN "X" IN SECTION BOX: 	4 DEPTH OF COMPLETED WELL 108 ft. ELEVATION:
	Depth(s) groundwater Encountered 1 ft. 2 ft. 3 ft.
WELL'S STATIC WATER LEVEL 45 FT. BELOW LAND SURFACE MEASURED ON 12/01/1995	
Pump test data: Well water was ft. after hours pumping gpm	
Est. Yield gpm: Well water was ft. after hours pumping gpm	
Bore Hole Diameter 12 in. to 108 ft. and in. to ft.	
WELL WATER TO BE USED AS: 5 Public water supply 8 Air conditioning 11 Injection well	
1 Domestic 3 Feedlot 6 Oil field water supply 9 Dewatering 12 Other (Specify below)	
2 Irrigation 4 Industrial 7 Lawn and garden only 10 Monitoring well	
Was a chemical/bacteriological sample submitted to Department? Yes No <input checked="" type="checkbox"/> ; If yes, mo/day/yr sample was submitted	
Water Well Disinfected? Yes <input checked="" type="checkbox"/> No	

5 TYPE OF CASING USED:	5 Wrought iron	8 Concrete tile	CASING JOINTS: Glued <input checked="" type="checkbox"/> Clamped
1 Steel	3 RMP (SR)	9 Other (Specify below)	Welded
2 PVC	4 ABS	SDR-26	Threaded
Blank casing Diameter 5 in. to 40 ft., Dia	in. to ft., Dia	in. to ft., Dia	in. to ft.
Casing height above land surface 12 in., weight 2.35 lbs./ft.	Wall thickness or gauge No. .214		
TYPE OF SCREEN OR PERFORATION MATERIAL:	7 PVC	10 Asbestos-cement	
1 Steel	3 Stainless Steel	5 Fiberglass	8 RMP (SR)
2 Brass	4 Galvanized steel	6 Concrete tile	9 ABS
SCREEN OR PERFORATION OPENING ARE:	5 Gauzed wrapped	8 Saw cut	11 None (open hole)
1 Continuous slot	3 Mill slot	9 Drilled holes	
2 Louvered shutter	4 Key punched	10 Other (specify)	
SCREEN-PERFORATION INTERVALS:	from 40 ft. to 108 ft., From	ft. to ft.	
GRAVEL PACK INTERVALS:	from 24 ft. to 108 ft., From	ft. to ft.	

6 GROUT MATERIAL:	1 Neat cement	2 Cement grout	3 Bentonite	4 Other
Grout Intervals: From 4 ft. to 24 ft. From	ft. From	ft. to	ft. From	ft. to
What is the nearest source of possible contamination:	10 Livestock pens	14 Abandon water well		
1 Septic tank	4 Lateral lines	7 Pit privy	11 Fuel storage	15 Oil well/Gas well
2 Sewer lines	5 Cess pool	8 Sewage lagoon	12 Fertilizer storage	16 Other (specify below)
3 Watertight sewer lines	6 Seepage pit	9 Feedyard	13 Insecticide storage	None Apparent
Direction from well?			How many feet?	

FROM	TO	LITHOLOGIC LOG	FROM	TO	PLUGGING INTERVALS
0	2	topsoil			
2	18	clay			
18	85	shale			
85	108	limestone and shale			

7 CONTRACTOR'S OR LANDOWNER'S CERTIFICATION: This water well was (1) constructed, (2) reconstructed, or (3) plugged under my jurisdiction and was completed on (mo/day/year)**12/01/1995**..... and this record is true to the best of my knowledge and belief. Kansas Water Well Contractor's License No.**236**..... This Water Well Record was completed on (mo/day/yr).....**12/04/95**..... Under the business name of.....**Harp Well & Pump Service, Inc**..... by (signature) *Jane Frederick*