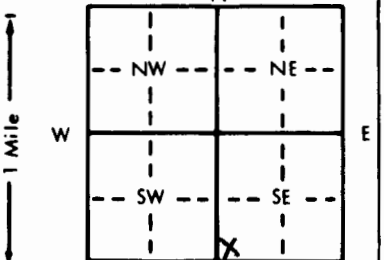


1 LOCATION OF WATER WELL: County: Sedgwick		Fraction SW 1/4 SW 1/4 SE 1/4	Section Number 16	Township Number T 27	Range Number R 2
Distance and direction from nearest town or city street address of well if located within city? 9109 E. Central					
2 WATER WELL OWNER: RR#, St. Address, Box # : City, State, ZIP Code			Raytheon Aircraft Company 9109 East Central Wichita, Kansas 67206		
			Board of Agriculture, Division of Water Resources Application Number:		
3 LOCATE WELL'S LOCATION WITH AN "X" IN SECTION BOX:		4 DEPTH OF COMPLETED WELL: 27.5 ft. ELEVATION:			
		Depth(s) Groundwater Encountered 1. 22.97 ft. 2. ft. 3. ft. WELL'S STATIC WATER LEVEL ft. below land surface measured on mo/day/yr Pump test data: Well water was ft. after hours pumping gpm Est. Yield gpm: Well water was ft. after hours pumping gpm Bore Hole Diameter 7.5 in. to 27.5 ft. and in. to ft. WELL WATER TO BE USED AS: 5 Public water supply 8 Air conditioning 11 Injection well 1 Domestic 3 Feedlot 6 Oil field water supply 9 Dewatering 12 Other (Specify below) 2 Irrigation 4 Industrial 7 Lawn and garden only ☒ Monitoring well Was a chemical/bacteriological sample submitted to Department? Yes No; If yes, mo/day/yr sample was submitted Water Well Disinfected? Yes No			
5 TYPE OF BLANK CASING USED:					
1 Steel 3 RMP (SR) 5 Wrought iron 8 Concrete tile CASING JOINTS: Glued Clamped ☒ PVC 4 ABS 6 Asbestos-Cement 9 Other (specify below) Welded 7 Fiberglass Threaded ☒ Blank casing diameter 2 in. to 17.5 ft. Dia in. to ft. Dia in. to ft. Casing height above land surface in. weight schedule 40 lbs./ft. Wall thickness or gauge No. TYPE OF SCREEN OR PERFORATION MATERIAL: ☒ PVC 10 Asbestos-cement 1 Steel 3 Stainless steel 5 Fiberglass 8 RMP (SR) 11 Other (specify) 2 Brass 4 Galvanized steel 6 Concrete tile 9 ABS 12 None used (open hole) SCREEN OR PERFORATION OPENINGS ARE: 5 Gauzed wrapped 8 Saw cut 11 None (open hole) 1 Continuous slot ☒ Mill slot 6 Wire wrapped 9 Drilled holes 2 Louvered shutter 4 Key punched 7 Torch cut 10 Other (specify) SCREEN-PERFORATED INTERVALS: From 29.5 ft. to 17.5 ft. From ft. to ft. From ft. to ft. From ft. to ft. GRAVEL PACK INTERVALS: From 27.5 ft. to 15.50 ft. From ft. to ft. From ft. to ft. From ft. to ft.					
6 GROUT MATERIAL: 1 Neat cement ☒ Cement grout ☒ Bentonite 4 Other					
Grout Intervals: From 13.5 ft. to 05 ft. From 15.5 ft. to 13.5 ft. From ft. to ft. What is the nearest source of possible contamination: 1 Septic tank 4 Lateral lines 7 Pit privy 10 Livestock pens 14 Abandoned water well ☒ Sewer lines 5 Cess pool 8 Sewage lagoon 11 Fuel storage 15 Oil well/Gas well 3 Watertight sewer lines 6 Seepage pit 9 Feedyard 12 Fertilizer storage 16 Other (specify below) 13 Insecticide storage Direction from well? 65' Northwest How many feet? 65'					
FROM		TO		LITHOLOGIC LOG	
				lithology not logged	
FROM		TO		PLUGGING INTERVALS	
7 CONTRACTOR'S OR LANDOWNER'S CERTIFICATION: This water well was ☒ constructed, ☐ reconstructed, or ☐ plugged under my jurisdiction and was completed on (mo/day/year) 1-8-96 and this record is true to the best of my knowledge and belief. Kansas Water Well Contractor's License No. 575 This Water Well Record was completed on (mo/day/yr) 1/8/96 under the business name of Kurtz Environmental Service by (signature) <i>[Signature]</i>					
INSTRUCTIONS: Use typewriter or ball point pen. PLEASE PRESS FIRMLY and PRINT clearly. Please fill in blanks, underline or circle the correct answers. Send top three copies to Kansas Department of Health and Environment, Bureau of Water, Topeka, Kansas 66620-0001. Telephone: 913-296-5545. Send one to WATER WELL OWNER and retain one for your records.					