

CORRECTION(S) TO WATER WELL RECORD (WWC-5)

(to rectify lacking or incorrect information)

County: Sedgwick

Location listed as:

Location changed to:

Section-Township-Range: 25-27 S-2 E

25-27 S-2 E

Fraction ($\frac{1}{4}$ $\frac{1}{4}$ $\frac{1}{4}$): SE NE SE

SW SW NW

Other changes: Initial statements: Butler County

Changed to: Sedgwick County

Comments: _____

verification method: Well owner's address, city street map on internet,
and Andover 1:24,000 topo. map.

initials: DRF date: 5/2/2006

1 LOCATION OF WATER WELL:	Fraction	Section Number	Township Number	Range Number
County: <u>Butler</u>	<u>SE 1/4 NE 1/4 SE 1/4</u>	<u>25</u>	T <u>27</u> S	R <u>2</u> <u>EN</u>

Distance and direction from nearest town or city street address of well if located within city?

2-W 1/2 S of Andover2 WATER WELL OWNER: Rebeka Fast 67230

RR#, St. Address, Box # :

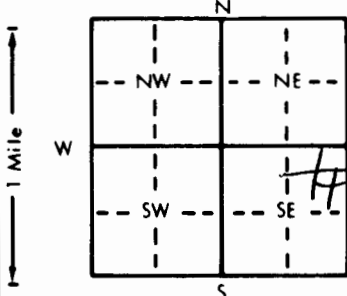
City, State, ZIP Code

14425 Laguna Wichita Kan

Board of Agriculture, Division of Water Resources

Application Number:

3 LOCATE WELL'S LOCATION WITH AN "X" IN SECTION BOX:

4 DEPTH OF COMPLETED WELL: 85 ft. ELEVATION:Depth(s) Groundwater Encountered 1. 60 ft. 2. ft. 3. ft.WELL'S STATIC WATER LEVEL 10 ft. below land surface measured on mo/day/yr

Pump test data: Well water was ft. after hours pumping gpm

Est. Yield 50 gpm; Well water was ft. after hours pumping gpmBore Hole Diameter 7 1/2 in. to ft., and in. to ft.

WELL WATER TO BE USED AS: 5 Public water supply 8 Air conditioning 11 Injection well

1 Domestic 3 Feedlot 6 Oil field water supply 9 Dewatering 12 Other (Specify below)

2 Irrigation 4 Industrial 7 Lawn and garden only 10 Monitoring wellWas a chemical/bacteriological sample submitted to Department? Yes No X; If yes, mo/day/yr sample was submittedWater Well Disinfected? Yes X No

5 TYPE OF BLANK CASING USED:

1 Steel 3 RMP (SR)

5 Wrought iron

8 Concrete tile

CASING JOINTS: Glued X Clamped2 PVC 4 ABS

6 Asbestos-Cement

9 Other (specify below)

Welded

7 Fiberglass

Threaded

Blank casing diameter 5 in. to 50 ft., Dia. in. to ft., Dia. in. to ft.Casing height above land surface 18 in., weight 160 lbs./ft. Wall thickness or gauge No. 214

TYPE OF SCREEN OR PERFORATION MATERIAL:

1 Steel 3 Stainless steel

5 Fiberglass

8 RMP (SR)

7 PVC 10 Asbestos-cement

2 Brass 4 Galvanized steel

6 Concrete tile

9 ABS

11 Other (specify)

12 None used (open hole)

SCREEN OR PERFORATION OPENINGS ARE:

1 Continuous slot

3 Mill slot

5 Gauzed wrapped

8 Saw cut

11 None (open hole)

2 Louvered shutter

4 Key punched

6 Wire wrapped

9 Drilled holes

2 Louvered shutter

7 Torch cut

10 Other (specify)

SCREEN-PERFORATED INTERVALS: From 50 ft. to 85 ft., From ft. to ft.

From ft. to ft., From ft. to ft.

GRAVEL PACK INTERVALS: From ft. to ft., From ft. to ft.

From ft. to ft., From ft. to ft.

6 GROUT MATERIAL:

1 Neat cement

2 Cement grout

3 Bentonite

4 Other

Grout Intervals: From 0 ft. to 20 ft., From ft. to ft., From ft. to ft.

What is the nearest source of possible contamination:

1 Septic tank

4 Lateral lines

7 Pit privy

10 Livestock pens

14 Abandoned water well

2 Sewer lines

5 Cess pool

8 Sewage lagoon

11 Fuel storage

15 Oil well/Gas well

3 Watertight sewer lines 6 Seepage pit

9 Feedyard

12 Fertilizer storage

16 Other (specify below)

13 Insecticide storage

Direction from well?

How many feet? 150

FROM TO LITHOLOGIC LOG FROM TO PLUGGING INTERVALS

0	5	Soil			
5	27	Clay			
27	85	Shale & Lime			

7 CONTRACTOR'S OR LANDOWNER'S CERTIFICATION: This water well was (1) constructed, (2) reconstructed, or (3) plugged under my jurisdiction and was completed on (mo/day/year) 2/24/96 and this record is true to the best of my knowledge and belief. KansasWater Well Contractor's License No. 251This Water Well Record was completed on (mo/day/yr) 3/6/96under the business name of Winter Well Drillby (signature) Charles Winter