


1	LOCATION OF WATER WELL: County: Sedgwick	Fraction 1/4 1/4 1/4 1/4 3/4 1/4	Section Number 26	Township Number T 27 S	Range Number R 2 E
---	---	--	----------------------	---------------------------	-----------------------

Distance and direction from nearest town or city street address of well if located within city?

13930 Bayley Wichita, KS 67230

2	WATER WELL OWNER: Tim Dieker	
	RR#, St. Address, Box # : 13930 Bayley	Board of Agriculture, Division of Water Resources
	City, State, ZIP Code : Wichita, KS 67230	Application Number:

3 LOCATE WELL'S LOCATION WITH AN "X" IN SECTION BOX: 4 DEPTH OF COMPLETED WELL..... 68 ft. ELEVATION:

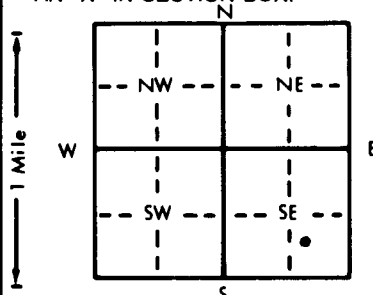

4 DEPTH OF COMPLETED WELL.....68..... ft. ELEVATION:

Depth(s) Groundwater Encountered 1. ft. 2. ft. 3. ft.
WELL'S STATIC WATER LEVEL 15 ft. below land surface measured on mo/day/yr 4/7/97

Pump test data: Well water was ft. after hours pumping gpm
 Est. Yield gpm: Well water was ft. after hours pumping gpm
 Bore Hole Diameter, 9 1/2 in. to 68 ft., and in. to ft.

WELL WATER TO BE USED AS:		5 Public water supply	8 Air conditioning	11 Injection well
1 Domestic	3 Feedlot	6 Oil field water supply	9 Dewatering	12 Other (Specify below)
2 Irrigation	4 Industrial	7 Lawn and garden only	10 Monitoring well	

Was a chemical/bacteriological sample submitted to Department? Yes.....No.....X...; If yes, mo/day/yr sample was submitted
 Water Well Disinfected? Yes X No

5 TYPE OF BLANK CASING USED:		5 Wrought iron	8 Concrete tile	CASING JOINTS: Glued ☒ Clamped ☐
1 Steel	3 RMP (SR)	6 Asbestos-Cement	9 Other (specify below)	Welded ☐
2 PVC	4 ABS	7 Fiberglass		Threaded ☐
Blank casing diameter 5 . . . in. to 40 . . . ft., Dia in. to ft., Dia in. to ft.				
Casing height above land surface 12 . . . in. weight lbs./ft. Wall thickness or gauge No. SDR26				

TYPE OF SCREEN OR PERFORATION MATERIAL:			⑦ PVC	10 Asbestos-cement
1 Steel	3 Stainless steel	5 Fiberglass	8 RMP (SR)	11 Other (specify)
2 Brass	4 Galvanized steel	6 Concrete tile	9 ABS	12 None used (open hole)

SCREEN OR PERFORATION OPENINGS ARE:

1 Continuous slot	3 Mill slot	5 Gauzed wrapped	8 Saw cut	11 None (open hole)
2 Louvered shutter	4 Key punched	6 Wire wrapped	9 Drilled holes	
		7 Torch cut	10 Other (specify)	

SCREEN-PERFORATED INTERVALS:	From 28 ft. to . . . 68 ft.,	From ft. to ft.
	From ft. to ft.,	From ft. to ft.
GRAVEL PACK INTERVALS:	From 20 ft. to . . . 68 ft.,	From ft. to ft.
	From ft. to ft.,	From ft. to ft.

6	GROUT MATERIAL:	1 Neat cement	2 Cement grout	3 Bentonite	4 Other
	Grout Interval:	From ft. to	From ft. to	From ft. to	From ft. to

What is the nearest source of possible contamination:		10 Livestock pens	14 Abandoned water well
1 Septic tank	4 Lateral lines	11 Fuel storage	15 Oil well/Gas well
2 Sewer lines	5 Cess pool	8 Sewage lagoon	16 Other (specify below)
3 Watertight sewer lines	6 Sewage pit	9 Sandbar	
		12 Fertilizer storage	
		13 Insecticide storage	

3 Watertight sewer lines	6 Seepage pit	9 Feedyard	13 Insecticide storage	
4	7	10	14	

[illegible]

7 CONTRACTOR'S OR LANDOWNER'S CERTIFICATION: This water well was (1) constructed, (2) reconstructed, or (3) plugged under my jurisdiction and was completed on (mo/day/year) 4/7/97 and this record is true to the best of my knowledge and belief. Kansas Water Well Contractor's License No. 171 This Water Well Record was completed on (mo/day/yr) 4/8/97 under the business name of G & S Drilling, Inc. by (signature)