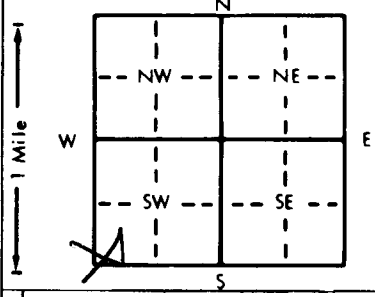


QT 383

1 LOCATION OF WATER WELL: County: <u>SEDGWICK</u> Fraction: <u>SW 1/4 SW 1/4 SW 1/4</u> Section Number: <u>15</u> Township Number: <u>T 27 S</u> Range Number: <u>R 20 EW</u>		
Distance and direction from nearest town or city street address of well if located within city? <u>11122 E. Central Wichita, KS</u>		
2 WATER WELL OWNER: <u>QT Corp</u> RR#, St. Address, Box #: <u>PO Box 3475</u> City, State, ZIP Code: <u>Tulsa, OK 74101</u> Application Number: <u>MW6 U2087803</u> Board of Agriculture, Division of Water Resources		
3 LOCATE WELL'S LOCATION WITH AN "X" IN SECTION BOX: 	4 DEPTH OF COMPLETED WELL: <u>25</u> ft. ELEVATION: Depth(s) Groundwater Encountered 1. ft. 2. ft. 3. ft. WELL'S STATIC WATER LEVEL ft. below land surface measured on mo/day/yr Pump test data: Well water was ft. after hours pumping gpm Est. Yield gpm: Well water was ft. after hours pumping gpm Bore Hole Diameter in. to ft., and in. to ft. WELL WATER TO BE USED AS: 5 Public water supply 8 Air conditioning 11 Injection well 1 Domestic 3 Feedlot 6 Oil field water supply 9 Dewatering 12 Other (Specify below) 2 Irrigation 4 Industrial 7 Lawn and garden only <u>10 Monitoring well</u> Was a chemical/bacteriological sample submitted to Department? Yes No <u>.....</u> ; If yes, mo/day/yr sample was submitted Water Well Disinfected? Yes No <u>.....</u>	
5 TYPE OF BLANK CASING USED: 1 Steel 3 RMP (SR) 5 Wrought iron 8 Concrete tile CASING JOINTS: Glued Clamped <u>2 PVC</u> 4 ABS 6 Asbestos-Cement 9 Other (specify below) <u>Welded</u> Blank casing diameter <u>2</u> in. to <u>10</u> ft., Dia in. to ft., Dia in. to ft. Casing height above land surface <u>0</u> in., weight lbs./ft. Wall thickness or gauge No. <u>Threaded</u> TYPE OF SCREEN OR PERFORATION MATERIAL: 1 Steel 3 Stainless steel 5 Fiberglass <u>7 PVC</u> 10 Asbestos-cement 2 Brass 4 Galvanized steel 6 Concrete tile 9 ABS 11 Other (specify) 12 None used (open hole) SCREEN OR PERFORATION OPENINGS ARE: 1 Continuous slot <u>3 Mill slot</u> 5 Gauzed wrapped 8 Saw cut 11 None (open hole) 2 Louvered shutter 4 Key punched 6 Wire wrapped 9 Drilled holes 7 Torch cut 10 Other (specify) SCREEN-PERFORATED INTERVALS: From <u>10</u> ft. to <u>25</u> ft., From ft. to ft. GRAVEL PACK INTERVALS: From <u>9</u> ft. to <u>25</u> ft., From ft. to ft. From ft. to ft., From ft. to ft.		
6 GROUT MATERIAL: 1 Neat cement 2 Cement grout <u>3 Bentonite</u> 4 Other Grout Intervals: From <u>0</u> ft. to ft., From <u>2</u> ft. to <u>9</u> ft., From ft. to ft. What is the nearest source of possible contamination: 1 Septic tank 4 Lateral lines 7 Pit privy 10 Livestock pens 14 Abandoned water well 2 Sewer lines 5 Cess pool 8 Sewage lagoon 11 Fuel storage 15 Oil well/Gas well 3 Watertight sewer lines 6 Seepage pit 9 Feedyard 12 Fertilizer storage <u>16 Other (specify below)</u> 13 Insecticide storage <u>WTS</u> Direction from well? How many feet?		
FROM TO LITHOLOGIC LOG FROM TO PLUGGING INTERVALS		
0 1	Topsoil	
5 7	Clay, minor silt, orange brn, gray green @ ~7'	
10 12	Clay, minor silt, gray green to gray brn	
15 17	Clay, minor silt, orange brn w/ ls frags, some iron staining	
20 22	Clay, orange brn, ls frags, shale?	
7 CONTRACTOR'S OR LANDOWNER'S CERTIFICATION: This water well was <u>(1)</u> constructed, (2) reconstructed, or (3) plugged under my jurisdiction and was completed on (mo/day/year) <u>4/2/97</u> and this record is true to the best of my knowledge and belief. Kansas Water Well Contractor's License No. <u>483</u> This Water Well Record was completed on (mo/day/year) <u>4/25/97</u> under the business name of <u>TEST</u> by (signature) <u>Robinson</u>		