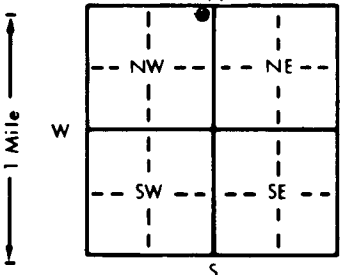


1 LOCATION OF WATER WELL:		Fraction	Section Number	Township Number	Range Number
County: <u>Sedgwick</u>		<u>NE</u> 1/4 <u>NE</u> 1/4 <u>UW</u> 1/4	<u>31</u>	T <u>27</u> S	R <u>2</u> <u>EW</u>
Distance and direction from nearest town or city street address of well if located within city? <u>6813 East Harry, Wichita, KS.</u>					
2 WATER WELL OWNER: <u>Rental World</u>					
RR#, St. Address, Box # : <u>6813 E. Harry</u> Board of Agriculture, Division of Water Resources					
City, State, ZIP Code : <u>Wichita, KS</u> Application Number:					
3 LOCATE WELL'S LOCATION WITH AN "X" IN SECTION BOX:		4 DEPTH OF COMPLETED WELL: <u>30'</u> ft. ELEVATION:			
		Depth(s) Groundwater Encountered <u>1.18'</u> ft. 2. ft. 3. ft.			
		WELL'S STATIC WATER LEVEL <u>23.8</u> ft. below land surface measured on mo/day/yr <u>5-29-97</u>			
		Pump test data: Well water was _____ ft. after _____ hours pumping _____ gpm			
		Est. Yield _____ gpm: Well water was _____ ft. after _____ hours pumping _____ gpm			
		Bore Hole Diameter <u>8 1/2"</u> in. to <u>30'</u> ft. and _____ in. to _____ ft.			
WELL WATER TO BE USED AS:					
1 Domestic 3 Feedlot 6 Oil field water supply 8 Air conditioning 11 Injection well					
2 Irrigation 4 Industrial 7 Lawn and garden only <u>10</u> Monitoring well 12 Other (Specify below)					
Was a chemical/bacteriological sample submitted to Department? Yes _____ No <u>X</u> If yes, mo/day/yr sample was submitted					
Water Well Disinfected? Yes _____ No <u>X</u>					
5 TYPE OF BLANK CASING USED:					
1 Steel 3 RMP (SR) 5 Wrought iron 8 Concrete tile CASING JOINTS: Glued _____ Clamped _____					
<u>2</u> PVC 4 ABS 6 Asbestos-Cement 9 Other (specify below) Welded _____					
7 Fiberglass _____ Threaded <u>X</u>					
Blank casing diameter <u>2.375</u> in. to <u>15'</u> ft., Dia _____ in. to _____ ft., Dia _____ in. to SDR <u>13</u> ft.					
Casing height above land surface <u>Flush Mt</u> in., weight _____ lbs./ft. Wall thickness or gauge No. <u>SCH 40</u>					
TYPE OF SCREEN OR PERFORATION MATERIAL:					
1 Steel 3 Stainless steel 5 Fiberglass 8 RMP (SR) 10 Asbestos-cement					
2 Brass 4 Galvanized steel 6 Concrete tile 9 ABS 11 Other (specify) _____					
12 None used (open hole)					
SCREEN OR PERFORATION OPENINGS ARE:					
1 Continuous slot <u>3</u> Mill slot 5 Gauzed wrapped 8 Saw cut 11 None (open hole)					
2 Louvered shutter 4 Key punched 6 Wire wrapped 9 Drilled holes					
7 Torch cut 10 Other (specify) _____					
SCREEN-PERFORATED INTERVALS: From <u>30'</u> ft. to <u>15'</u> ft., From _____ ft. to _____ ft.					
From _____ ft. to _____ ft., From _____ ft. to _____ ft.					
GRAVEL PACK INTERVALS: From <u>30'</u> ft. to <u>13'</u> ft., From _____ ft. to _____ ft.					
From _____ ft. to _____ ft., From _____ ft. to _____ ft.					
6 GROUT MATERIAL:					
1 Neat cement 2 Cement grout 3 Bentonite 4 Other _____					
Grout Intervals: From <u>13'</u> ft. to <u>4'</u> ft., From <u>4'</u> ft. to <u>0'</u> ft., From _____ ft. to _____ ft.					
What is the nearest source of possible contamination:					
1 Septic tank 4 Lateral lines 7 Pit privy <u>1</u> Fuel storage 10 Livestock pens 14 Abandoned water well					
2 Sewer lines 5 Cess pool 8 Sewage lagoon 12 Fertilizer storage 15 Oil well/Gas well					
3 Watertight sewer lines 6 Seepage pit 9 Feedyard 13 Insecticide storage 16 Other (specify below)					
Direction from well? <u>In old Tank Pub</u> How many feet? <u>0'</u>					
FROM		TO	LITHOLOGIC LOG	FROM	TO
0		.75	Concrete	PLUGGING INTERVALS	
.75		2.50	Med gray-brn to gray mottled clay fill, moist to dry, faint odor.		
2.50		5	Fine-very coarse sand, dry, faint odor, fill.		
5		8	Gray mottled clay, moist, firm, no odor.		
8		19.5	Gray green clay w/ brn clay mottling, fine-coarse sand & gravel stringers, moist, faint odor, firm.		
19.5		21	Yellow brn clay w/ green gray clay mottling, faint odor.	Flush mt. OK'd by Don Taylor	
21		25	Yellow brn mottled weathered shale.		
25		30	Olive gray shaley clay, no odor.		
7 CONTRACTOR'S OR LANDOWNER'S CERTIFICATION: This water well was (1) <u>constructed</u> , (2) reconstructed, or (3) plugged under my jurisdiction and was completed on (mo/day/year) <u>5-27-97</u> and this record is true to the best of my knowledge and belief. Kansas Water Well Contractor's License No. <u>539</u> This Water Well Record was completed on (mo/day/yr) <u>5-29-97</u> under the business name of <u>JB Environmental Drilling</u> by (signature) <u>James Beebe</u>					
INSTRUCTIONS: Use typewriter or ball point pen. PLEASE PRESS FIRMLY and PRINT clearly. Please fill in blanks, underline or circle the correct answers. Send top three copies to Kansas Department of Health and Environment, Bureau of Water, Topeka, Kansas 66620-0001. Telephone: 913-296-5545. Send one to WATER WELL OWNER and retain one for your records.					

OFFICE USE ONLY

T

R

EW

SEC.

1/4

1/4

1/4