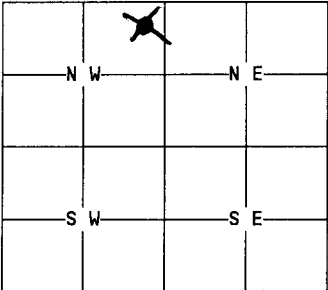


1 LOCATION OF WATER WELL: County: Sedgwick	Fraction NE 1/4 NE 1/4 NW 1/4	Section Number 24	Township Number 27 S	Range Number 2 E
---	----------------------------------	----------------------	-------------------------	---------------------

Distance and direction from nearest town or city street address of well if located within city?
3 miles East of Wichita, KS

2 WATER WELL OWNER: Glen Kubina RR#, St. Address, Box #: #11 Swallow City, State, ZIP Code : Wichita, KS 67230	Board of Agriculture, Division of Water Resources Application Number: N/A
--	--

3 MARK WELL'S LOCATION WITH AN "X" IN SECTION BOX: N  S	4 DEPTH OF WELL: 150-150-150-200-...ft. 200-200-200 WELL'S STATIC WATER LEVEL.....ft. WELL WAS USED AS: <table style="width:100%;"> <tr> <td>1 Domestic</td> <td>5 Public Water Supply</td> <td>9 Dewatering</td> </tr> <tr> <td>2 Irrigation</td> <td>6 Oil Field Water Supply</td> <td>10 Monitoring Well</td> </tr> <tr> <td>3 Feedlot</td> <td>7 Lawn and Garden Only</td> <td>11 Injection Well</td> </tr> <tr> <td>4 Industrial</td> <td>8 Air Conditioning</td> <td>12 Other..Heat Pump.....</td> </tr> </table> 3 @ 150 ft. ea. & 4 @ 200 ft. ea. Was a chemical/bacteriological sample submitted to Department? Yes....No <u>XX</u> . If yes, mo/day/yr sample was submitted..... Water Well Disinfected: Yes..... No <u>X</u> ...	1 Domestic	5 Public Water Supply	9 Dewatering	2 Irrigation	6 Oil Field Water Supply	10 Monitoring Well	3 Feedlot	7 Lawn and Garden Only	11 Injection Well	4 Industrial	8 Air Conditioning	12 Other..Heat Pump.....
1 Domestic	5 Public Water Supply	9 Dewatering											
2 Irrigation	6 Oil Field Water Supply	10 Monitoring Well											
3 Feedlot	7 Lawn and Garden Only	11 Injection Well											
4 Industrial	8 Air Conditioning	12 Other..Heat Pump.....											

5 TYPE OF BLANK CASING USED:
1 Steel 3 RMP (SR) 5 Wrought 7 Fiberglass X Other (specify below)
2 PVC 4 ABS 6 Asbestos-Cement 8 Concrete Tile Polyethylene.....
Blank casing diameter...3/4....in. Was casing pulled? Yes..... No..X... If yes, how much.....
Casing height above or below land surface.....in.

6 GROUT PLUG MATERIAL: 1 Neat cement 2 Cement grout X Bentonite 4 Other.....
Grout Plug Intervals: From 0...ft. to 150.ft., From 0...ft. to 150.ft., From 0.. to 150.ft.
from 0 to 200 from 0 to 200 from 0 to 200
What is the nearest source of possible contamination:

1 Septic tank	6 Seepage pit	11 Fuel storage	16 Other (specify below)
<u>X</u> 2 Sewer lines	7 Pit privy	12 Fertilizer storage	
3 Watertight sewer lines	8 Sewage lagoon	13 Insecticide storage	
4 Lateral lines	9 Feedyard	14 Abandoned water well	
5 Cess Pool	10 Livestock pens	15 Oil well/Gas well	

Direction from well? ..East..... How many feet? ...100.....

FROM	TO	PLUGGING MATERIALS
0	2	Topsoil
2	7	Tan Clay
7	48	Gray Shale
48	51	Loose Shale
51	69	Gray Shale
69	85	Red Shale
85	106	Gray Shale

7 CONTRACTOR'S OR LANDOWNER'S CERTIFICATION: This water well was plugged under my jurisdiction and was completed on (mo/day/year) 10/05/98..... and this record is true to the best of my knowledge and belief. Kansas Water Well Contractor's License No. 138..... This Water Well Record was completed on (mo/day/year) 10/29/98..... under the business name of Peterson Irrigation, Inc.	by (signature) <u>Mike Peterson</u>
--	-------------------------------------

INSTRUCTIONS: Use typewriter or ball point pen. Please press firmly and print clearly. Please fill in blanks, underline or circle the correct answers. Send top three copies to Kansas Department of Health and Environment, Bureau of Water, Topeka, Kansas 66620-0001. Telephone: 913/296-3565. Send one to Water Well Owner and retain one for your records.