

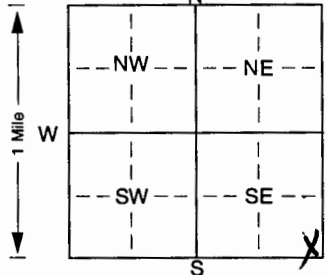
2511131

WATER WELL RECORD

Form WWC-5

KSA 82a-1212 ID No.

00307404

1 LOCATION OF WATER WELL:		Fraction	Section Number	Township Number	Range Number
County: Sedgwick		SE 1/4 SE 1/4 SE 1/4	21	T 27 S	R 2 (EW)
Distance and direction from nearest town or city street address of well if located within city? 11134 E. Kellogg					
2 WATER WELL OWNER: Universal Motor Fuels RR#, St. Address, Box #: PO Box 2930 City, State, ZIP Code: Wichita KS 67201					
Board of Agriculture, Division of Water Resources Application Number: 1349.13					
3 LOCATE WELL'S LOCATION WITH AN "X" IN SECTION BOX:		4 DEPTH OF COMPLETED WELL: 25 ft. ELEVATION: 1349.13			
		Depth(s) Groundwater Encountered: 1 Dry ft. 2. ft. 3. ft. WELL'S STATIC WATER LEVEL: 21.16 ft. below land surface measured on mo/day/yr 10/13/00 Pump test data: Well water was ft. after hours pumping gpm Est. Yield gpm: Well water was ft. after hours pumping gpm Bore Hole Diameter: 8.5 in. to 25 ft. and in. to ft. WELL WATER TO BE USED AS: 5 Public water supply 8 Air conditioning 11 Injection well 1 Domestic 3 Feedlot 6 Oil field water supply 9 Dewatering 12 Other (Specify below) 2 Irrigation 4 Industrial 7 Domestic (lawn & garden) 10 Monitoring well MW-13			
Was a chemical/bacteriological sample submitted to Department? Yes. No. X If yes, mo/day/yr sample was submitted					
Water Well Disinfected? Yes No X					
5 TYPE OF BLANK CASING USED:					
1 Steel		3 RMP (SR)	5 Wrought iron	8 Concrete tile	CASING JOINTS: Glued. Clamped.
2 PVC		4 ABS	6 Asbestos-Cement	9 Other (specify below)	Welded
Blank casing diameter: 2 in. to 15 ft. Dia		7 Fiberglass	Threaded FULL		
Casing height above land surface: Flush in, weight: 7.03 lbs./ft. Wall thickness or gauge No. Sch 40					
TYPE OF SCREEN OR PERFORATION MATERIAL:					
1 Steel		3 Stainless steel	5 Fiberglass	8 RMP (SR)	10 Asbestos-cement
2 Brass		4 Galvanized steel	6 Concrete tile	9 ABS	11 Other (specify)
12 None used (open hole)					
SCREEN OR PERFORATION OPENINGS ARE:					
1 Continuous slot		3 Mill slot	5 Gauzed wrapped	8 Saw cut	11 None (open hole)
2 Louvered shutter		4 Key punched	6 Wire wrapped	9 Drilled holes	
7 Torch cut 10 Other (specify) ft.					
SCREEN-PERFORATED INTERVALS: From 15 ft. to 25 ft. From ft. to ft.					
GRAVEL PACK INTERVALS: From 13 ft. to 25 ft. From ft. to ft.					
6 GROUT MATERIAL: 1 Neat cement 2 Cement grout 3 Bentonite 4 Other					
Grout Intervals: From 1.5 ft. to 13 ft. From ft. to ft. From ft. to ft.					
What is the nearest source of possible contamination:					
1 Septic tank		4 Lateral lines	7 Pit privy	10 Livestock pens	14 Abandoned water well
2 Sewer lines		5 Cess pool	8 Sewage lagoon	11 Fuel storage	15 Oil well/Gas well
3 Watertight sewer lines		6 Seepage pit	9 Feedyard	12 Fertilizer storage	16 Other (specify below)
Direction from well? How many feet?					
FROM	TO	LITHOLOGIC LOG	FROM	TO	PLUGGING INTERVALS
0	1	Topsoil			
1	5	Clay			
5	10	Clay/Weathered Shale			
10	25	Clay/Weathered Shale			
Note: Nine wells were originally installed. Six of the wells were then plugged. GSI is utilizing the original Waiver.					
7 CONTRACTOR'S OR LANDOWNER'S CERTIFICATION: This water well was (1) constructed, (2) reconstructed, or (3) plugged under my jurisdiction and was completed on (mo/day/year) 11/29/00 and this record is true to the best of my knowledge and belief. Kansas Water Well Contractor's Licence No. 531 This Water Well Record was completed on (mo/day/yr) 12/6/00 under the business name of Geotechnical Services, Inc. by (signature) Allison M. Smith					
INSTRUCTIONS: Use typewriter or ball point pen. PLEASE PRESS FIRMLY and PRINT clearly. Please fill in blanks, underline or circle the correct answers. Send top three copies to Kansas Department of Health and Environment, Bureau of Water, Topeka, Kansas 66620-0001. Telephone 785-296-5524. Send one to WATER WELL OWNER and retain one for your records. Fee of \$5.00 for each constructed well.					