

1 LOCATION OF WATER WELL:	Fraction	Section Number	Township Number	Range Number
County: <u>SEDGWICK</u>	<u>NE 1/4 NE 1/4 SW 1/4</u>	<u>20</u>	T <u>27</u> S	R <u>2</u> <u>EW</u>


Distance and direction from nearest town or city street address of well if located within city?

8301 E Douglas Wichita KSMW 75-5

2 WATER WELL OWNER:	Board of Agriculture, Division of Water Resources
RR#, St. Address, Box #:	Application Number:
City, State, ZIP Code:	

Raytheon Aircraft Co9709 E CENTRALWichita KS 67206

3 LOCATE WELL'S LOCATION WITH AN "X" IN SECTION BOX:	4 DEPTH OF COMPLETED WELL: <u>32</u> ft. ELEVATION:
--	---

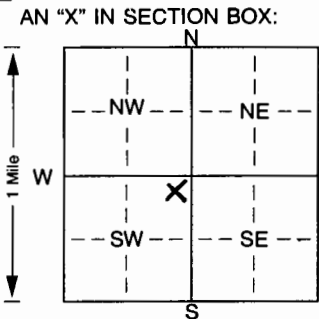

Depth(s) Groundwater Encountered 1. ft. 2. ft. 3. ft.

WELL'S STATIC WATER LEVEL ft. below land surface measured on mo/day/yr

Pump test data: Well water was ft. after hours pumping gpm

Est. Yield gpm: Well water was ft. after hours pumping gpm

Bore Hole Diameter. 7.114 in. to 3.2 ft., and. in. to ft.

WELL WATER TO BE USED AS: 5 Public water supply 8 Air conditioning 11 Injection well

1 Domestic 3 Feedlot 6 Oil field water supply 9 Dewatering 12 Other (Specify below)

2 Irrigation 4 Industrial 7 Domestic (lawn & garden) ☒ Monitoring well

Was a chemical/bacteriological sample submitted to Department? Yes. No. ; If yes, mo/day/yr sample was submitted

Water Well Disinfected? Yes No

5 TYPE OF BLANK CASING USED:	5 Wrought iron	8 Concrete tile	CASING JOINTS: Glued. Clamped.
------------------------------	----------------	-----------------	--

1 Steel 3 RMP (SR)

6 Asbestos-Cement

9 Other (specify below)

Welded

☒ PVC 4 ABS

7 Fiberglass

Threaded. ☒

Blank casing diameter in. to ft., Dia in. to ft., Dia in. to ft.

Casing height above land surface. in., weight Sched 40 lbs./ft. Wall thickness or gauge No.

TYPE OF SCREEN OR PERFORATION MATERIAL:

1 Steel 3 Stainless steel

5 Fiberglass

☒ PVC

10 Asbestos-cement

2 Brass 4 Galvanized steel

6 Concrete tile

8 RMP (SR)

11 Other (specify)

9 ABS

12 None used (open hole)

SCREEN OR PERFORATION OPENINGS ARE:

1 Continuous slot

☒ Mill slot 0.10

5 Gauzed wrapped

8 Saw cut

11 None (open hole)

2 Louvered shutter

4 Key punched

6 Wire wrapped

9 Drilled holes

7 Torch cut

10 Other (specify) ft.

SCREEN-PERFORATED INTERVALS: From. ft. to ft., From ft. to ft.

From. ft. to ft., From ft. to ft.

GRAVEL PACK INTERVALS: From. ft. to ft., From ft. to ft.

From. ft. to ft., From ft. to ft.

6 GROUT MATERIAL:	1 Neat cement	☒ Cement grout	☒ Bentonite	4 Other
-------------------	---------------	---	--	-------------------

Grout Intervals: From. ft. to ft., From ft. to ft., From ft. to ft.

What is the nearest source of possible contamination:

1 Septic tank

4 Lateral lines

7 Pit privy

10 Livestock pens

14 Abandoned water well

2 Sewer lines

5 Cess pool

8 Sewage lagoon

11 Fuel storage

15 Oil well/Gas well

☒ Watertight sewer lines 6 Seepage pit

9 Feedyard

12 Fertilizer storage

16 Other (specify below)

13 Insecticide storage

Direction from well?

SouthwestHow many feet? 125'

FROM	TO	LITHOLOGIC LOG	FROM	TO	PLUGGING INTERVALS
0	64	Concrete	30	31	Limestone shale & gravel
64	21	Fill	31	32	Dark gray shale
21	5	Dark brown silty clay			
5	10	Silty clay yellow brown			
10	10.5	Clayey sand pinkish brown			
10.5	131	Clay sand silty red brown			
131	20.25	Olive green silty clay			
20.25	23	Olive green silty clay w Colicche			
23	27	tan silty clay			
27	29	light olive gray clays silt			
29	30	light gray sand & gypsum			

7 CONTRACTOR'S OR LANDOWNER'S CERTIFICATION: This water well was ☒ constructed, (2) reconstructed, or (3) plugged under my jurisdiction and was completed on (mo/day/year) and this record is true to the best of my knowledge and belief. Kansas Water Well Contractor's Licence No. This Water Well Record was completed on (mo/day/yr) under the business name of <u>FUNKER DRILLING SERVICE INC</u> by (signature) <u>John Funker</u>
--