

# CORRECTION TO WATER WELL RECORD (WWC-5)

The following correction(s) was made to the attached WWC-5 log, in order to file the item or to rectify lacking or incorrect information.

Fraction ( 1/4 1/4 1/4) Section-Township-Range changed:

listed as SW NW NW, 24-27-1

changed to NW NE SE, 8-27S-2E

Other changes: Initial statements: \_\_\_\_\_

Changed to: \_\_\_\_\_

Comments: \_\_\_\_\_

verification method: Well address on form, city map, and

Wichita East 1:24,000 topo. map.

initials: DRF date: 9/20/2001

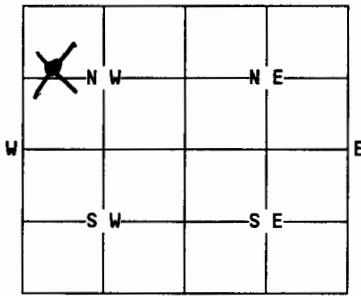
submitted by: Kansas Geological Survey, Data Resources Library, 1930 Constant Ave., Lawrence, KS 66047-3726  
to: Kansas Dept of Health & Environment Bureau of Water Industrial Programs, Bldg 283, Forbes Field, KS 66620

1	LOCATION OF WATER WELL:	Fraction	Section Number	Township Number	Range Number
County:	Sedgwick	SW 1/4 NW 1/4 NW 1/4	24	27	1

Distance and direction from nearest town or city street address of well if located within city?

In City Limits-1720 Barrier Cove, Wichita

2	WATER WELL OWNER: Davis Construction 1720 Barrier Cove RR#, St. Address, Box #: City, State, ZIP Code: Wichita, KS 67201	Board of Agriculture, Division of Water Resources Application Number:
---	---	--

3	MARK WELL'S LOCATION WITH AN "X" IN SECTION BOX: N  S	4	DEPTH OF WELL <u>150-135-120</u> .....ft. WELL'S STATIC WATER LEVEL.....ft. WELL WAS USED AS: 1 Domestic 5 Public Water Supply 9 Dewatering 2 Irrigation 6 Oil Field Water Supply 10 Monitoring Well 3 Feedlot 7 Lawn and Garden Only 11 Injection Well 4 Industrial 8 Air Conditioning 12 Other <u>Heat Pump</u>  9 @ 150; 3 @ 135; 4 @ 120ft Was a chemical/bacteriological sample submitted to Department? Yes....No. <u>X</u> . If yes, mo/day/yr sample was submitted..... Water Well Disinfected: Yes... <u>X</u> ... No.....
---	---	---	--

5	TYPE OF BLANK CASING USED: 1 Steel 3 RMP (SR) 5 Wrought 7 Fiberglass 9 Other (specify below) 2 PVC 4 ABS 6 Asbestos-Cement 8 Concrete Tile <u>Polyethylene</u> Blank casing diameter... <u>3/4</u> ...in. Was casing pulled? Yes..... No..... If yes, how much..... Casing height above or below land surface.....in.
---	---

6	GROUT PLUG MATERIAL: 1 Neat cement 2 Cement grout <u>3 Bentonite</u> 4 Other..... Grout Plug Intervals: From <u>0</u> ...ft. to <u>150</u> ...ft., From <u>0</u> ...ft. to <u>135</u> ...ft., From <u>0</u> ... to <u>120</u> ...ft. What is the nearest source of possible contamination: 1 Septic tank 6 Seepage pit 11 Fuel storage 16 Other (specify below) 2 Sewer lines 7 Pit privy 12 Fertilizer storage 3 Watertight sewer lines 8 Sewage lagoon 13 Insecticide storage 4 Lateral lines 9 Feedyard 14 Abandoned water well 5 Cess Pool 10 Livestock pens 15 Oil well/Gas well Direction from well? ... <u>West</u> ..... How many feet? .... <u>30</u> ...ft.....
---	---

FROM	TO	PLUGGING MATERIALS
0	2	Top Soil
2	17	Tan Clay
17	75	Gray Shale
75	82	Limestone
82	101	Gray Shale
101	103	Limestone
103	131	Gray Shale

131 143 Limestone  
143 150 Gray Shale

7	CONTRACTOR'S OR LANDOWNER'S CERTIFICATION: This water well was plugged under my jurisdiction and was completed on (mo/day/year) <u>6-20-95</u> and this record is true to the best of my knowledge and belief. Kansas Water Well Contractor's License No. <u>138</u> This Water Well Record was completed on (mo/day/year) <u>6-20-95</u> by (signature) <u>Mike Peterson</u> under the business name of <u>Peterson Irrigation Inc.</u>
---	--

INSTRUCTIONS: Use typewriter or ball point pen. Please press firmly and print clearly. Please fill in blanks, underline or circle the correct answers. Send top three copies to Kansas Department of Health and Environment, Bureau of Water, Topeka, Kansas 66620-0001. Telephone: 913/296-3565. Send one to Water Well Owner and retain one for your records.