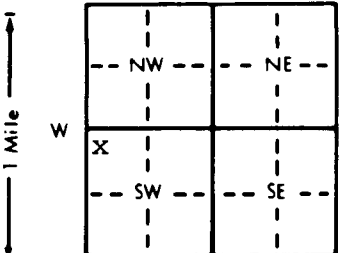


1 LOCATION OF WATER WELL:		Fraction	Section Number	Township Number		Range Number	
County: SEDGWICK		NW 1/4 NW 1/4 SW 1/4	10	T 27 S		R 2 EW	
Distance and direction from nearest town or city street address of well if located within city?							
1/2 MILE NORTH OF 13th OF EAST SIDE OF GREENWICH RD						MW#SAL 15	
2 WATER WELL OWNER: RAYTHEON AIRCRAFT CO.							
RR#, St. Address, Box #: 9709 EAST CENTRAL				Board of Agriculture, Division of Water Resources			
City, State, ZIP Code: WICHITA, KS 67206				Application Number:			
3 LOCATE WELL'S LOCATION WITH AN "X" IN SECTION BOX:		4 DEPTH OF COMPLETED WELL: 40 ft. ELEVATION:					
		Depth(s) Groundwater Encountered 1. ft. 2. ft. 3. ft.					
		WELL'S STATIC WATER LEVEL ft. below land surface measured on mo/day/yr					
		Pump test data: Well water was ft. after hours pumping gpm					
		Est. Yield gpm: Well water was ft. after hours pumping gpm					
		Bore Hole Diameter 7 1/4 in. to 40 ft., and in. to ft.					
		WELL WATER TO BE USED AS: 5 Public water supply 8 Air conditioning 11 Injection well					
		1 Domestic 3 Feedlot 6 Oil field water supply 9 Dewatering 12 Other (Specify below)					
		2 Irrigation 4 Industrial 7 Lawn and garden only X Monitoring well					
		Was a chemical/bacteriological sample submitted to Department? Yes No; If yes, mo/day/yr sample was submitted					
		Water Well Disinfected? Yes No					
5 TYPE OF BLANK CASING USED:							
1 Steel		3 RMP (SR)		5 Wrought iron		8 Concrete tile	
X PVC		4 ABS		6 Asbestos-Cement		9 Other (specify below)	
Blank casing diameter 2 in. to 25 ft., Dia				7 Fiberglass		CASING JOINTS: Glued Clamped	
Casing height above land surface 0 in., weight sched 40 lbs./ft.						Welded	
TYPE OF SCREEN OR PERFORATION MATERIAL:						X Threaded	
1 Steel		3 Stainless steel		5 Fiberglass		8 RMP (SR)	
2 Brass		4 Galvanized steel		6 Concrete tile		9 ABS	
SCREEN OR PERFORATION OPENINGS ARE:						10 Asbestos-cement	
1 Continuous slot		X3 Mill slot 0.10		5 Gauzed wrapped		8 Saw cut	
2 Louvered shutter		4 Key punched		6 Wire wrapped		9 Drilled holes	
SCREEN-PERFORATED INTERVALS:		From 40 ft. to 25 ft.		7 Torch cut		10 Other (specify)	
		From ft. to ft.					
GRAVEL PACK INTERVALS:		From 40 ft. to 23 ft.					
		From ft. to ft.					
6 GROUT MATERIAL: 1 Neat cement X 2 Cement grout X3 Bentonite 4 Other							
Grout Intervals: From 20 ft. to 0.03 ft., From 23 ft. to 20 ft., From ft. to ft.							
What is the nearest source of possible contamination:							
1 Septic tank		4 Lateral lines		7 Pit privy		10 Livestock pens	
2 Sewer lines		5 Cess pool		8 Sewage lagoon		11 Fuel storage	
X Watertight sewer lines		6 Seepage pit		9 Feedyard		12 Fertilizer storage	
						13 Insecticide storage	
Direction from well? west						How many feet? 1050	
FROM TO		LITHOLOGIC LOG		FROM TO		PLUGGING INTERVALS	
0 3		CLAYEY DARK BRN SILT					
3 6		SILTY DARK BRN CLAY					
6 8		SILTY GRAY BRN CLAY					
8 10		STIFF PLASTIC SILTY BRN CLAY					
10 18		SILTY YELLOW BRN HIGH PLASTIC CLAY					
18 25		LIGHT OLIVE BRN SILTY CLAY					
25 30		WEATHERED LIGHT GRAY OLIVE SHALE					
30 33		PALE YELLOW SILT SATURATED SOME CALCAREOUS SHALE					
33 38.5		OLIVE AND PALE OLIVE BROKEN SHALE & SILT					
38.5 40		OLIVE SHALE					
7 CONTRACTOR'S OR LANDOWNER'S CERTIFICATION: This water well was (1) constructed, (2) reconstructed, or (3) plugged under my jurisdiction and was completed on (mo/day/year) 5-26-98 and this record is true to the best of my knowledge and belief. Kansas Water Well Contractor's License No. 575 This Water Well Record was completed on (mo/day/yr) 7-12-98 under the business name of KURTZ ENVIRONMENTAL SERVICE by (signature)							
INSTRUCTIONS: Use typewriter or ball point pen. PLEASE PRESS FIRMLY and PRINT clearly. Please fill in blanks, underline or circle the correct answers. Send two copies to Kansas Department of Health and Environment, Bureau of Water, Topeka, Kansas 66620-0001. Telephone: 913-296-5545. Send one to WATER WELL OWNER and retain one for your records.							