

1] LOCATION OF WATER WELL: Fraction SE 1/4 SE 1/4 SE 1/4 Section Number 18 Township Number T 27 S Range Number R 2 E
 County: Sedgewick
 Distance and direction from nearest town or city street address of well if located within city?

2990 E. Central, Wichita, KS MW 8


2] WATER WELL OWNER: Former Coastal Mart #9166

RR#, St. Address, Box #: 7990 E. Central
 City, State, ZIP Code: Wichita, KS 67201

Board of Agriculture, Division of Water Resources
 Application Number:

3] LOCATE WELL'S LOCATION WITH 4] DEPTH OF COMPLETED WELL 17 ft. ELEVATION:

AN "X" IN SECTION BOX:

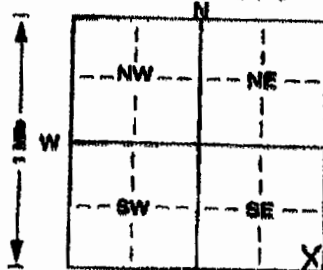

Depth(s) Groundwater Encountered 1. 0 ft. 2. 0 ft. 3. 0 ft.

WELL'S STATIO WATER LEVEL 0 ft. below land surface measured on mo/day/yr

Pump test data: Well water was 0 ft. after 0 hours pumping

Est. Yield 0 gpm: Well water was 0 ft. after 0 hours pumping

Bore Hole Diameter 8 in. to 17 ft., and 0 in. to 0 ft.

WELL WATER TO BE USED AS: 5 Public water supply 8 Air conditioning 11 Injection well

1 Domestic 3 Feedlot 6 Oil field water supply 9 Dewatering 12 Other (Specify below)

2 Irrigation 4 Industrial 7 Domestic (lawn & garden) 10 Monitoring well

Was a chemical/bacteriological sample submitted to Department? Yes No X; If yes, mo/day/yr sample was

mitted

Water Well Disinfected? Yes No X

5] TYPE OF BLANK CASING USED:

1 Steel 3 RMP (SR) 5 Wrought iron 8 Concrete tile CASING JOINTS: Glued Clamped

2 PVC 4 ABS 6 Asbestos-Cement 9 Other (specify below) Welded Threaded X

Blank casing diameter 2 in. to 7 ft., Dia 0 in. to 0 ft., Dia 0 in. to 0 ft., Dia

Casing height above land surface 0 in., weight 0 lbs./ft. Wall thickness or gauge No. 5 4 9

TYPE OF SCREEN OR PERFORATION MATERIAL: 7 PVC 10 Asbestos-cement

1 Steel 3 Stainless steel 8 RMP (SR) 11 Other (specify)

2 Brass 4 Galvanized steel 9 ABS 12 None used (open hole)

SCREEN OR PERFORATION OPENINGS ARE: 5 Gauzed wrapped 8 Saw cut 11 None (open hole)

1 Continuous slot 3 Mill slot 9 Wire wrapped 10 Drilled holes

2 Louvered shutter 4 Key punched 7 Torch out 10 Other (specify)

SCREEN-PERFORATED INTERVALS: From 0 ft. to 17 ft., From 0 ft. to 0 ft.,

GRAVEL PACK INTERVALS: From 0 ft. to 17 ft., From 0 ft. to 0 ft.,

From 0 ft. to 0 ft., From 0 ft. to 0 ft.,

From 0 ft. to 0 ft., From 0 ft. to 0 ft.,

From 0 ft. to 0 ft., From 0 ft. to 0 ft.,

6] GROUT MATERIAL: 1 Neat cement 2 Cement grout 3 Bentonite 4 Other

Grout intervals: From 0 ft. to 5 ft., From 0 ft. to 0 ft., From 0 ft. to 0 ft.,

What is the nearest source of possible contamination:

1 Septic tank 4 Lateral lines 7 Pit privy 10 Livestock pens 14 Abandoned water well

2 Sewer lines 5 Cess pool 8 Sewage lagoon 11 Fuel storage 15 Oil well/Gas well

3 Watertight sewer lines 6 Sepsage pit 9 Feedyard 12 Fertilizer storage 16 Other (specify below)

Direction from well? SOUTH 13 Insecticide storage

How many feet? 10

FROM TO LITHOLOGIC LOG FROM TO FLUGGING INTERVALS

0 8 Sandy Clay, BRN, med plst, dry 0 0

8 10 Sandy Clay, BRN, med plst, wet 0 0

10 17 Sandy Clay, gy, med-h plst, dry 0 0

0 0 0 0

0 0 0 0

CONTRACTOR'S OR LANDOWNER'S CERTIFICATION: This water well was (1) constructed, (2) reconstructed, or (3) plugged under my jurisdiction and completed on (mo/day/year) 7-9-02 and this record is true to the best of my knowledge and belief. I, Water Well Contractor's License No. 604 This Water Well Record was completed on (mo/day/yr) 7-18-02 under the business name of Handex by (signature) [Signature]

INSTRUCTIONS: Use typewriter or ball point pen. PLEASE PRINT CLEARLY and PRINT clearly. Please fill in circles, underline or circle the correct answers. Send top three copies to Kansas Department of Health